

1308 CACIQUE ST - NEW SECOND RESIDENTIAL UNIT

COPYRIGHT,
2017 BY THOMAS OCHSNER.
ALL RIGHTS RESERVED.
NO PART OF THIS DRAWING MAY
BE
REPRODUCED.



THOMAS OCHSNER
Architect

ARCHITECTURE & PLANNING

Thomas
Ochsner AIA
Architect

1847 State Street
Santa Barbara, CA 93101
Tel 805.770.7576
Cel 805.705.6558
tom@toarchitect.com
www.toarchitect.com

CLIENT

Emilio Ruggiero

PROJECT

DETACHED
ACCESSORY
DWELLING UNIT

1308 CACIQUE ST, SANTA
BARBARA, CA, 93101

SHEET TITLE

COVER SHEET

REVISIONS



PROJECT NAME DETACHED ACCESSORY
DWELLING UNIT

DATE DRAWN

DATE 12/21/2020

SHEET NO.

T-1.0

BMP DESCRIPTION:

- PROJECT PROVIDED 25% NATURAL VEGETATED AREA
- PERMEABLE PAVERS

SPECIAL INSPECTIONS

TBD, SEE STRUCTURAL

OBSERVATION & TESTING PROGRAM:

INSPECTIONS SHALL BE CALLED IN BY CONTRACTOR FOR INSPECTION 72 HOURS PRIOR TO NEEDED INSPECTION. THE CITY WILL THEN ROUTE TO THE OSP INSPECTOR OR THIRD PARTY COMPANY

FINAL PLANS
STRIPPING AND CLEARING OF VEGETATION
RECOMPACTION OF SCARIFICATION SOILS
FILL PLACEMENT AND COMPACTION
FOOTING EXCAVATIONS
PREMOISTENING OF SUBSLAB SOILS
FINAL REPORT INCLUDING PAD CERTIFICATION
INSPECTION REQUIRED TO VERIFY THAT THE BMP'S HAVE BEEN INSTALLED CORRECTLY

FIRE DEPARTMENT NOTES:

- FIRE SPRINKLER SUBMITTAL AND INSTALLATION UNDER SEPARATE PERMIT
- FIRE SPRINKLER SYSTEM TO COMPLY WITH NFPA 13D

GRADING

CUT	21 CY
FILL	21 CY
IMPORT	0 CY
EXPORT	0 CY

PROJECT TEAM

OWNER: EMILIO RUGGIERO
(CONTACT APPLICANT)
805-617-5527

ARCHITECT: THOMAS OCHSNER
1847 STATE STREET
SANTA BARBARA, CA 93101
(805) 770-7576

SURVEYOR: DODSON LAND SURVEYING
4568 ALHAY DR.
SANTA BARBARA, CA 93110
(805) 882-1615

STRUCTURAL ENGINEER:

CIVIL ENGINEER:

CODE COMPLIANCE

ALL WORK AND MATERIALS SHALL BE PERFORMED AND INSTALLED IN COMPLIANCE WITH THE CURRENT EDITIONS OF THE FOLLOWING CODES AS ADOPTED BY THE LOCAL GOVERNING AUTHORITIES. NOTHING IN THESE PLANS IS TO BE CONSTRUED TO PERMIT WORK NOT CONFORMING TO THESE CODES.

COUNTY AIR POLLUTION CONTROL DISTRICT REQUIREMENTS.
2019 CALIFORNIA BUILDING ADMINISTRATIVE CODE, PART 1
2019 CALIFORNIA BUILDING CODE, PART 2
2019 CALIFORNIA RESIDENTIAL CODE, PART 2.5
2019 CALIFORNIA ELECTRICAL CODE, PART 3
2019 CALIFORNIA MECHANICAL CODE, PART 4
2019 CALIFORNIA PLUMBING CODE, PART 5
2019 CALIFORNIA ENERGY CODE, PART 6
2019 CALIFORNIA FIRE CODE, PART 9
2019 CALIFORNIA GREEN BUILDING STANDARDS CODE, PART 11
2019 CALIFORNIA REFERENCED STANDARDS CODE, PART 12
2019 CALIFORNIA CODE, TITLE 24 CD-ROM
2019 CALIFORNIA TITLE 24 COMPLETE COLLECTION
NATIONAL ELECTRIC CODE
FEDERAL - OSHA

SHEET INDEX

SHEET #	DRAWING TITLE
T-1.0	COVER SHEET
T-1.2	SITE PHOTOS
T-1.4	TESTING REPORTS
T-1.5	TESTING REPORTS
A-1.0	SITE PLAN
A-2.1	PROPOSED FLOOR PLANS
A-5.0	PROPOSED SECTIONS
A-6.2	PROPOSED EXTERIOR ELEVATIONS
A-8.2	DOOR AND WINDOW SCHEDULE
A-9.1	ARCHITECTURAL DETAILS
E-1	LIGHTING & POWER PLANS
TOTAL SHEETS: 11	

PROJECT DESCRIPTION

PROPOSAL FOR A NEW 2-STORY SECOND RESIDENTIAL UNIT
EXTENSION OF (E) DRIVEWAY TO ALLOW FOR 2 PARKING SPACES. NEW SINGLE CAR CARPORT.

THIS IS A PHASE 2 OF THE DEVELOPMENT ON THIS PROPERTY. PHASE ONE CONSISTED OF CONVERTING AN EXISTING 2-CAR GARAGE TO AN ACCESSORY DWELLING UNIT. PHASE ONE HAS BEEN APPROVED BY THE PLANNING DEPARTMENT AND IS CURRENTLY IN PLANCHECK IN BUILDING DEPARTMENT.

ALL VIOLATIONS ON THE PROPERTY ARE TO BE ABATED UNDER PHASE 1.

THIS PROJECT MUST COMPLY WITH TIER 2 (2020) POST-CONSTRUCTION STORM WATER REQUIREMENTS

- REQUIRED BMP'S (CUMULATIVE OF BOTH PHASES)
- PROJECT PROVIDED 25% NATURAL VEGETATED AREA
- PERMEABLE PAVERS

PROJECT DATA

APN: 017233018

JOB ADDRESS: 1308 CACIQUE ST
SANTA BARBARA CA

ZONE: R-M

LOT SIZE (NET): 6,771 SQ FT

OCCUPANCY TYPE: R-3

TYPE OF CONSTRUCTION: TYPE - VB

STORIES
EXISTING 2
PROPOSED 2

ALLOWABLE MAX HEIGHT: 25 FT

SPRINKLERS:
EXISTING RESIDENCE NO
NEW DEVELOPMENT NO

HIGH FIRE AREA: NO

SQUARE FOOTAGE

EXISTING STRUCTURES	NET	GROSS
MAIN RESIDENCE:	901 SF	965 SF
TOTAL (E) RESIDENCE	901 SF	965 SF

DETACHED ACCESSORY DWELLING UNIT (PERMITTED UNDER A SEPARATE PERMIT)		
FIRST FLOOR	328 SF	375 SF
SECOND FLOOR	297 SF	338 SF
TOTAL ADU	625 SF	713 SF


PROPOSED STRUCTURES		
NEW SECOND RESIDENTIAL UNIT		
FIRST FLOOR	575 SF	641 SF
SECOND FLOOR	542 SF	595 SF
TOTAL SECOND RESIDENTIAL UNIT	1117 SF	1236 SF
BOTH RESIDENTIAL UNITS COMBINED	2542 SF	2701 SF
TOTAL DEVELOPMENT ON SITE	3170 SF	3414 SF

PROPOSED ACCESSORY STRUCTURES		
ONE CAR DETACHED CARPORT	163 SF	
TOTAL EXISTING AND PROPOSED OF ACCESSORY STRUCTURES ON SITE	163 SF	

PARKING REQUIREMENTS

EXISTING	0
DEMOLISHED	0
REQUIRED	2 (PRIMARY UNIT PARKING WAS CONVERTED TO AN ADU AND NOT REPLACED, REDUCING THE REQUIRED NUMBER OF PARKINGS SPACES FROM 4 TO 2)
PROPOSED	2 (ONE COVERED , ONE UNCOVERED)
TOTAL	2

VICINITY MAP

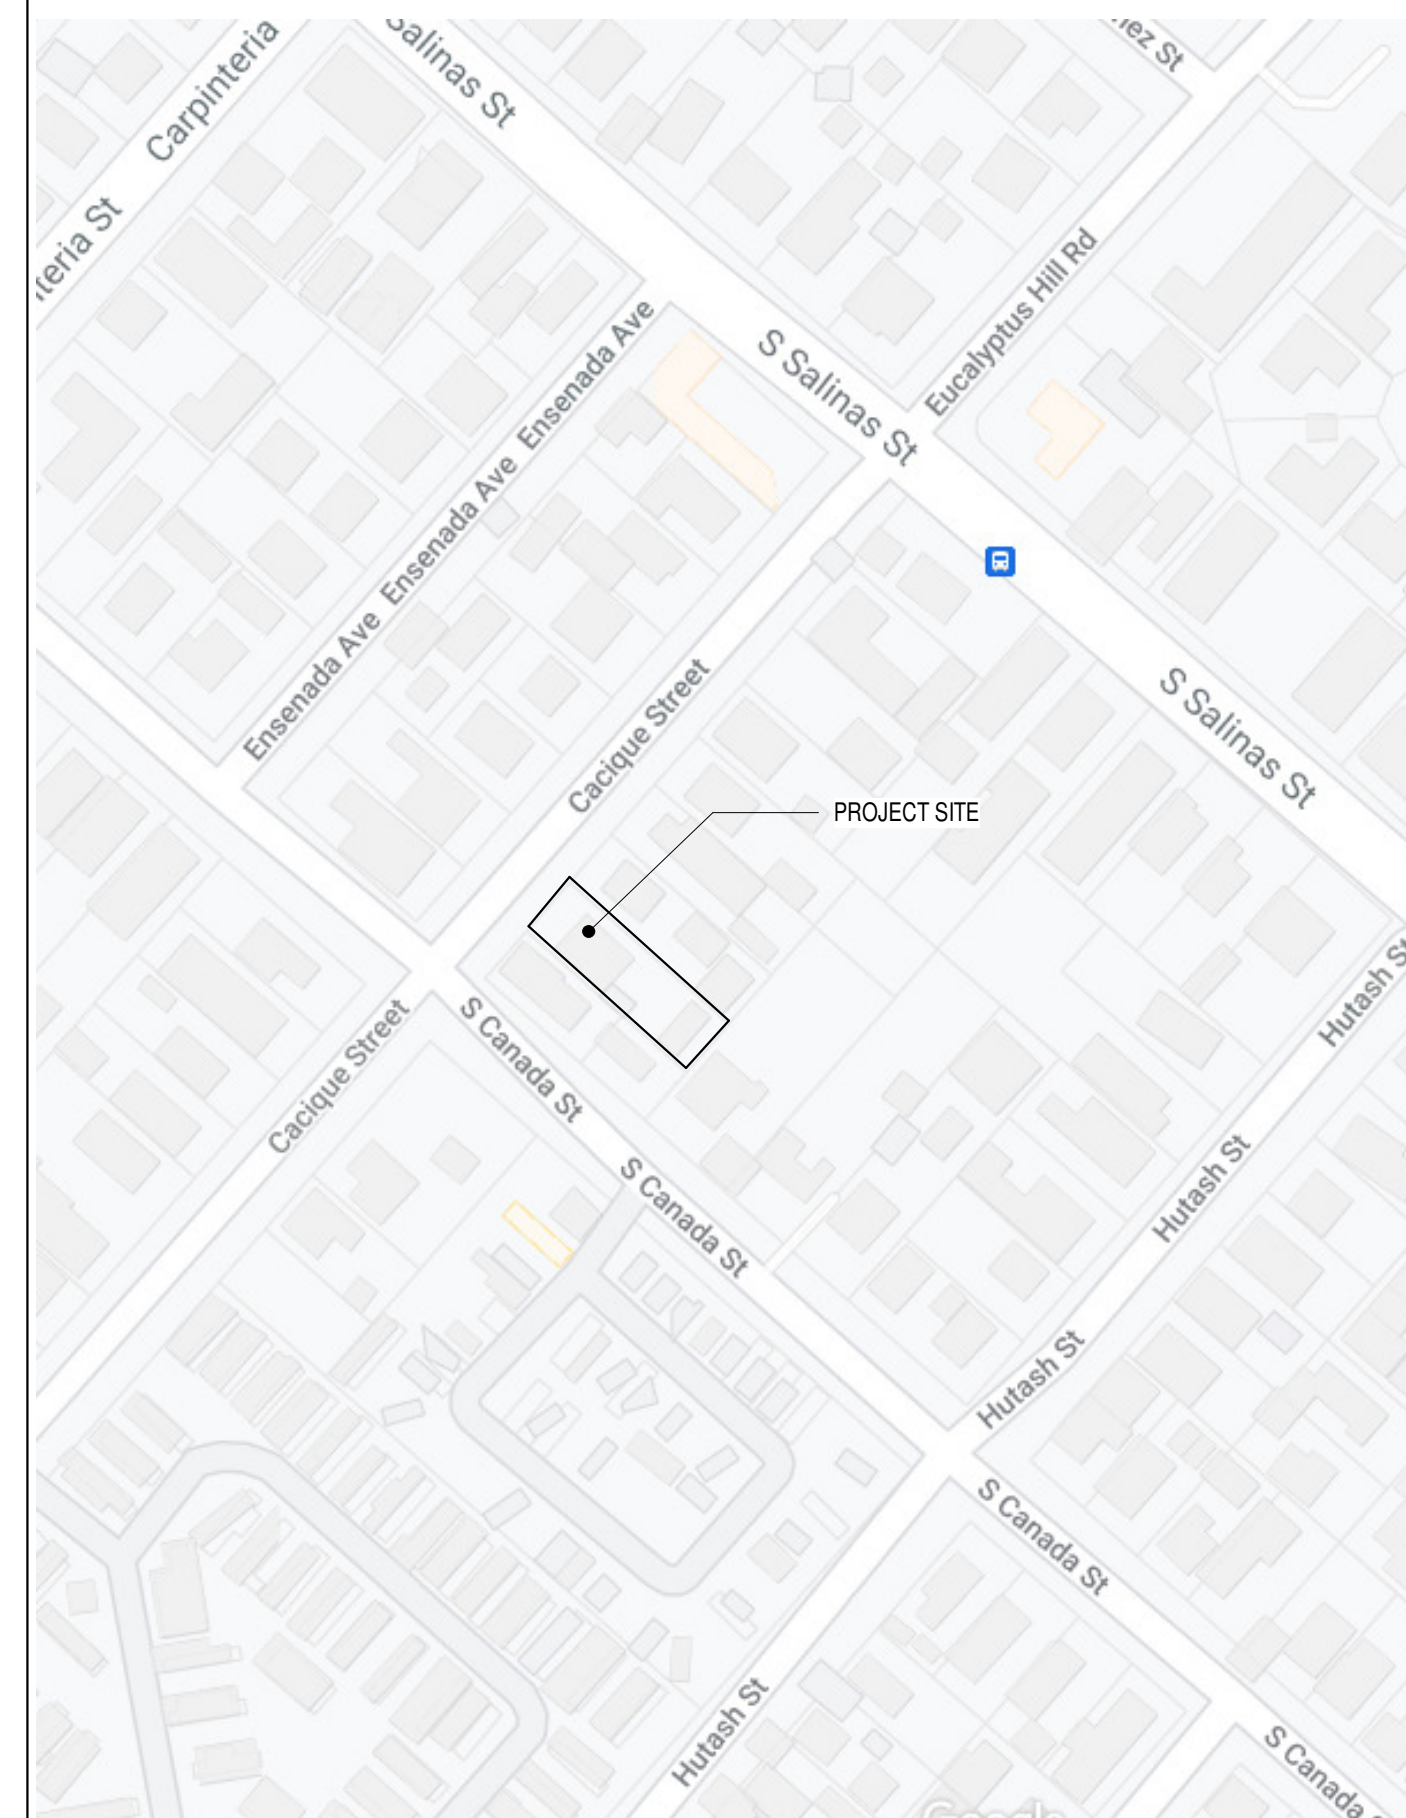

NEW IMPERVIOUS AREAS: 707 SF
REPLACED IMPERVIOUS AREAS: 1132 SF
REMOVED IMPERVIOUS AREAS: 1355 SF

TIER 2 SWMP IS REQ'D FOR THIS PROJECT



THOMAS OCHSNER
Architect

ARCHITECTURE & PLANNING

Thomas
Ochsner AIA
Architect

1847 State Street
Santa Barbara, CA 93101
Tel 805.770.7576
Cel 805.705.6558
tom@toarchitect.com
www.toarchitect.com

CLIENT

Emilio Ruggiero

PROJECT


DETACHED
ACCESSORY
DWELLING UNIT

1308 CACIQUE ST, SANTA
BARBARA, CA, 93101

SHEET TITLE

SITE PHOTOS

REVISIONS

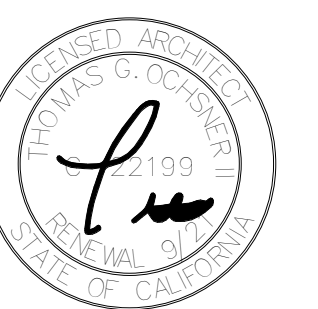

PROJECT NAME DETACHED ACCESSORY
DWELLING UNIT

DATE DRAWN

DATE 12/21/2020

SHEET NO.

T-1.2



MAIN HOUSE TO REMAIN (PHOTO 01)

MAIN HOUSE TO REMAIN (PHOTO 02)



ROOFING SPECIFICATION

BORAL ROOFING
Build something great™



PRODUCT INFORMATION



Profile:	Duralite Saxony 600 Slate
Color Name:	Charcoal Blend
SKU Number:	2FACS1430LR
Product Type:	Lightweight
Color:	Tan, Multicolor, Brown
Available Regions:	Arizona, Southern California

Cool Rated Product

Reflectivity:	0.17
Aged Ref. (3 yr):	0.17
Emmissivity:	0.91
Aged Em. (3 yr):	0.93
SRI:	16
Aged SRI (3 yr):	17
CRRC ID#:	0072
Seller ID#:	0942

*Calculated Aged Value
The greatest color shown here may vary from actual available tile color and should not be used to color match. Please contact your local Sales Representative for actual tile samples.

1.800.669.TILE (8453)
www.BoralRoof.com

	Solar Reflectance	Initial	Weathered
	Thermal Emittance	0.17	0.17
		0.91	0.93
	Rated Product ID Number	0072	
	Licensed Seller ID Number	0942	
	Classification	Production Line	

Cool Roof Rating Council ratings are determined for a fixed set of conditions, and may not be appropriate for determining seasonal energy performance. The actual effect of solar reflectance and thermal emittance on building performance may vary.
Manufacturer of product stipulates that these ratings were determined in accordance with the applicable Cool Roof Rating Council procedures.

EVALUATION REPORT

Number: **412**

Originally Issued: 07/31/2015 Revised: 03/29/2020 Valid Through: 07/31/2021

BORAL ROOFING
7575 Irvine Center Drive, Suite 100
Irvine, California 92618
(949) 756-1605
www.BoralRoof.com

3.0 PRODUCT USE

3.1 **General:** Boral Roofing Concrete Roof Tiles shall be used as a roof covering in accordance with IBC Section 1503 or IRC Section 903, as applicable.

CONCRETE ROOF TILES

CSI Section:
07 32 16 Concrete Roof Tiles

1.0 RECOGNITION

Boral Roofing Concrete Roof Tiles recognized in this report have been evaluated for use as concrete roof tiles. The weather resistance, wind uplift resistance and fire classification properties of the roof tiles comply with the intent of the provisions of the following codes and regulations:

- 2018, 2015, 2012, 2009, and 2006 International Building Code® (IBC)
- 2018, 2015, 2012, 2009, and 2006 International Residential Code® (IRC)
- 2019 California Building Code (CBC) – Supplement attached
- 2019 California Residential Code (CRC) – Supplement attached
- 2020 Florida Building Code, Building (FBC, Building) – Supplement attached
- 2020 Florida Building Code, Residential (FBC, Residential) – Supplement attached

2.0 LIMITATIONS

Use of the Boral Roofing Concrete Roof Tiles recognized in this report is subject to the following limitations:

2.1 The roof tiles shall be manufactured, identified and installed in accordance with this report and the applicable code. In the event of a conflict this report governs.

2.2 Boral Roofing "concrete roof tile" shall be installed on roof slopes of 2 1/2 units vertical in 12 units horizontal (21-percent slope) or greater. IBC Section 1507.3.2.

2.3 The supporting structure shall be designed to support the loads and is beyond the scope of this report.

2.4 The Concrete Roof Tiles recognized in this report are manufactured in Lake Wales, FL; Brookshire, TX; Phoenix, AZ; Henderson, NV; Okcechobee, FL; Rialto, CA; French Camp, CA; Henderson, CO and Lathrop, CA; Tables 2 A through 2 I describe the tiles produced at each location.

TABLE 1 – ATTACHMENT DESIGN

Applicable Code	Criteria for Applicability	Design Information Location
2015 or 2006 IBC	Ultimate Design Wind Speeds (V _e) ≥ 130 MPH and Mean Roof Height ≤ 60 feet	Roof Tile Installation Manual & Table 1507.3.7 of the applicable IBC
2009 or 2006 IBC	Basic Wind Speed (V _e) (see gust) ≤ 100 mph and Mean Roof Height ≤ 60 feet	Roof Tile Installation Manual & Section R905.3.7
2015, 2012, 2009 or 2006 IRC	Mean Roof Height ≤ 40 feet	Roof Tile Installation Manual & Section R905.3.7

For SF: 1 foot = 305 mm, 1 mph = 1.6 m/s

3.3 **Anchoring:** Boral Concrete Roof tiles may be anchored using mortar in accordance with the applicable building code and, where permitted, the TRI Manual or adhesively attached in accordance with the adhesive manufacturer's research report issued by an approved evaluation service agency.

EVALUATION REPORT

Number: **412**

Originally Issued: 07/31/2015 Revised: 03/29/2020 Valid Through: 07/31/2021

4.0 PRODUCT DESCRIPTION

Boral Roofing Concrete Roof Tiles comply with ASTM C1492 as required by Section 1507.3.5 of the IBC. The roof tiles are described by model, weight, dimensions, and tile factor in Tables 2 A through 2 I, for each of the production locations listed in Section 2.4 of this report. When installed in accordance with this report on minimum 15/32-inch-thick (12 mm) plywood solid sheathing or non-combustible decks, the assembly incorporating the roof tiles achieve an ASTM E108 Class A rating per Section 1505.2 of the IBC and Section R902.1 of the IRC, as applicable. Roof classifications for adhesively attached systems shall be in accordance with the adhesive manufacturer's approved research report.

4.1 Accessories:


Boral EnviroPro[®] recognized in this report has been evaluated for use as an accessory product to be used with concrete roof tiles. The weather resistance, wind uplift resistance and fire classification properties of the product complies with the intent of the provisions of the codes and regulations in Section 1.0 of this report. The Boral EnviroPro product is subject to all limitations in Section 2.0 of this report. The Boral EnviroPro product complies with ASTM C1492 as required by Section 1507.3.5 of the IBC. The Boral EnviroPro product is described by model, weight, dimensions, and tile factor in Tables 2 A through 2 I, for each of the production locations listed in Section 2.4 of this report. When installed in accordance with this report on minimum 15/32-inch-thick (12 mm) plywood solid sheathing or non-combustible decks, the assembly incorporating the Boral EnviroPro product achieves an ASTM E108 Class A rating per Section 1505.2 of the IBC and Section R902.1 of the IRC, as applicable.

4.1.1 Installation:

The Boral EnviroPro accessory product shall be limited to installation where roof tiles must be cut, such as in valleys and boundary edges at rakes, walls, chimneys, skylights, and other roof openings and penetrations. The installed dry weight of Boral EnviroPro is equivalent to that of the tile profile in Tables 2A-2I with which it is used.

5.0 IDENTIFICATION

Shipping pallets are identified with the report holder's name (Boral Roofing), manufacturing address, product name, installed weight, inspection agency, and evaluation report number (ER-412). The Cedarite 600, Madera 700 and Madera 900 tiles are imprinted on the top side of each tile with an "M", all other field tiles are imprinted with the name "Boral", "Boral Lifetime", "MonierLifeTile", or the Boral Roofing, or MonierLifeTile or "Vostite" or logo. The Boral EnviroPro product shall be clearly identified to provide distinction between field tiles and accessory tiles as stated in the EnviroPro product installation guidelines. The identification includes the IAPMO Uniform Evaluation Service Mark of Conformity. Either Mark of Conformity may be used as follows:

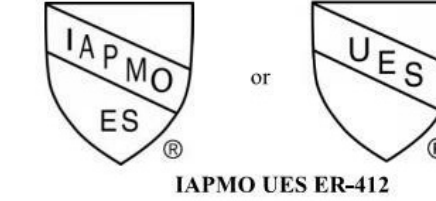

6.0 SUBSTANTIATING DATA

Data in accordance with ICC-ES AC108, dated February 2012 (editorially revised March 2018), manufacturer's descriptive literature and installation instructions. Test reports are from laboratories in compliance with ISO/IEC 17025.

7.0 STATEMENT OF RECOGNITION

This evaluation report describes the results of research completed by IAPMO Uniform Evaluation Service on Boral Roofing Concrete Roof Tiles to assess conformance to the codes shown in Section 1.0 of this report and serves as documentation of the product certification. Products are manufactured at locations noted in Section 2.4 of this report under a quality control program with periodic inspection under the supervision of IAPMO UES.

For additional information about this evaluation report please visit www.auditors.com or email us at info@auditors.com

EVALUATION REPORT

Number: **412**

Originally Issued: 07/31/2015 Revised: 03/29/2020 Valid Through: 07/31/2021

Table 2 A – Tiles Manufactured at Denver (Henderson), CO

Tile	Installed Dry Weight ¹ (psf)	Dimensions ² (inch)		Tile Factor	
		Length X Width	TF (ft ²)	Ratio ¹	
Saxony – Shake, Slate, Country Slate Split Old English Thatch	9.6	17 X 13	1.568	1.115	
Saxony – Impact	10.5	17 X 13	1.568	1.115	
Villa 900	9.0	17 X 13	1.503	1.068	
Villa – Impact	10.1	17 X 13	1.503	1.068	

For SF: 1 inch = 25.4 mm, 1 psf = 4.88 kg/m²

Table 2 B – Tiles Manufactured at Henderson, NV

Tile	Installed Dry Weight ¹ (psf)	Dimensions ² (inch)		Tile Factor	
		Length X Width	TF (ft ²)	Ratio ¹	
Espana / Barcelona	9.0	17 X 12 1/2	1.470	1.045	
Saxony 900 – Shake, Slate, Country Slate	9.1	17 X 13	1.533	1.090	

For SF: 1 inch = 25.4 mm, 1 psf = 4.88 kg/m²

Table 2 C – Tiles Manufactured at Katy (Brookshire), TX

Tile	Installed Dry Weight ¹ (psf)	Dimensions ² (inch)		Tile Factor	
		Length X Width	TF (ft ²)	Ratio ¹	
Barcelona – Impact	10.3	16 1/2 X 13	1.444	1.027	
Saxony – Country Shake, Country Slate, Country Split Shake, English Thatch	10.3	16 1/2 X 13	1.392	0.989	
Saxony – Impact	10.5	16 1/2 X 13	1.392	0.989	
Saxony – Shake, Slate	10.3	16 1/2 X 13	1.392	0.989	
Texas Espana / Barcelona	9.0	16 1/2 X 13	1.407	1.000	
Villa	9.0	16 1/2 X 13	1.407	1.000	

For SF: 1 inch = 25.4 mm, 1 psf = 4.88 kg/m²

NOTES TO TABLES:
1. Used on a 3-inch head-lap.
2. Nominal dimension.

EVALUATION REPORT

Number: **412**

Originally Issued: 07/31/2015 Revised: 03/29/2020 Valid Through: 07/31/2021

Table 2 D – Tiles Manufactured at Lake Wales, FL

Tile	Installed Dry Weight ¹ (psf)	Dimensions ² (inch)		Tile Factor	
		Length X Width	TF (ft ²)	Ratio ¹	
Barcelona 900	9.5	17 X 13	1.525	1.084	
Saxony 900 – Shake, Slate, Split Shake, Country Slate	9.5	17 X 13	1.545	1.098	
Spanish "S" Navco	9.9	17 X 9 1/4	1.144	0.813	
Villa 900	9.2	17 X 13	1.533	1.090	

For SF: 1 inch = 25.4 mm, 1 psf = 4.88 kg/m²

Table 2 E – Tiles Manufactured at Lathrop, CA

Tile	Installed Dry Weight ¹ (psf)	Dimensions ² (inch)		Tile Factor	
		Length X Width	TF (ft ²)	Ratio ¹	
Barcelona 900	9.3	17 X 13	1.509	1.073	
Saxony 900 – Shake, Slate	9.1	17 X 13	1.533	1.090	

For SF: 1 inch = 25.4 mm, 1 psf = 4.88 kg/m²

Table 2 F – Tiles Manufactured at Phoenix, AZ

Tile	Installed Dry Weight ¹ (psf)	Dimensions ² (inch)		Tile Factor	
		Length X Width	TF (ft ²)	Ratio ¹	
Mission S / Barcelona	10.2	16 1/2 X 13	1.494	1.062	
Saxony – Shake, Slate	9.5	16 1/2 X 13	1.494	1.062	
Villa	9.0	16 1/2 X 13	1.407	1.000	

For SF: 1 inch = 25.4 mm, 1 psf = 4.88 kg/m²

Table 2 G – Tiles Manufactured at Okcechobee, FL

Tile	Installed Dry Weight ¹ (psf)	Dimensions ² (inch)		Tile Factor	
		Length X Width	TF (ft ²)	Ratio ¹	
Bermuda	12.44	16 1/2 X 10 1/2	1.026	0.736	
Estate "S"	7.9	16 1/2 X 13	1.417	1.007	
Galena Spanish "S"	9.3	17 X 10	1.444	0.831	
Plantation	10.4	16 1/2 X 13	1.426	1.014	
Saxony 900	9.3	17 X 13	1.533	1.090	

For SF: 1 inch = 25.4 mm, 1 psf = 4.88 kg/m²

NOTES TO TABLES:
1. Used on a 3-inch head-lap.
2. Nominal dimension.

EVALUATION REPORT

Number: **412**

Originally Issued: 07/31/2015 Revised: 03/29/2020 Valid Through: 07/31/2021

Table 2 H – Tiles Manufactured at Rialto, CA

Tile	Installed Dry Weight ¹ (psf)	Dimensions ² (inch)		Tile Factor	
		Length X Width	TF (ft ²)	Ratio ¹	
Espana / Barcelona	9.0	17 X 12 1/2	1.454	1.033	
Espana 600 / Barcelona 600	5.9	17 X 12 1/2	1.454	1.033	
Saxony 600 – Slate, Shake, Split Shake	5.9	17 X 13	1.533	1.090	
Saxony 700 – Slate, Shake, Split Shake	7.1	17 X 13	1.533	1.090	
Saxony 900 – Slate, Shake, Country Shake	9.3	17 X 13	1.533	1.090	
Villa 600	5.8	17 X 13	1.494	1.061	
Villa 900	9.0	17 X 13	1.494	1.061	

For SF: 1 inch = 25.4 mm, 1 psf = 4.88 kg/m²

Table 2 I – Tiles Manufactured at Stockton (French Camp), CA

Tile	Installed Dry Weight ¹ (psf)	Dimensions ² (inch)		Tile Factor	
		Length X Width	TF (ft ²)	Ratio ¹	
Cedarite 600	5.9	13 1/2 X 13	0.942	0.673	
Madera 700	7.2	13 1/2 X 13	0.947	0.673	
Madera 900	9.5	13 1/2 X 13	0.947	0.673	
Saxony 600 – Slate, Shake, Split Shake	5.7	17 X 13	1.525	1.084	
Saxony 700 – Slate, Shake, Split Shake	7.2	17 X 13	1.525	1.084	
Saxony 900 – Hartford Slate, Shake, Slate, Country Slate	9.1	17 X 13	1.533	1.090	
Saxony 900 – Split Old English Thatch	9.8	17 X 13	1.525	1.084	
Villa 600	6.0	17 X 13	1.494	1.115	
Villa 900	9.3	17 X 13	1.494	1.115	

For SF: 1 inch = 25.4 mm, 1 psf = 4.88 kg/m²

NOTES TO TABLES:
1. Used on a 3-inch head-lap.
2. Nominal dimension.

EVALUATION REPORT

Number: **412**

Originally Issued: 07/31/2015 Revised: 03/29/2020 Valid Through: 07/31/2021

CALIFORNIA SUPPLEMENT

BORAL ROOFING
7575 Irvine Center Drive, Suite 100
Irvine, California 92618
(949) 756-1605
www.boralamerica.com

CONCRETE ROOF TILES

CSI Section:
07 32 16 Concrete Roof Tiles

1.0 RECOGNITION

The Boral Roofing Concrete Roof Tiles and accessories evaluated in IAPMO UES ER-412 are satisfactory alternative roof covering materials in accordance with the following codes and regulations:

- 2019 California Building Code (CBC)
- 2019 California Residential Code (CRC)

2.0 PRODUCT USE

2.1 The Boral Roofing concrete roof tiles may be used as a Class A, B, or C roof covering systems complying with Sections 1505.1.1 of the CBC or R902.1.1 of the CRC; Sections 1505.1.2 of the CBC or R902.1.2 of the CRC; or Sections 1505.1.3 of the CBC or R902.1.3 of the CRC, respectively. The design and installation of the Boral Roofing concrete roof tiles shall be in accordance with Sections 1507.3.10 and 1513 CBC or Section 905.3 of the CRC, as applicable, and ER-412.

2.2 Roof Tiles shall be installed in accordance with Sections 3.0 and 4.0 of ER-412 except, where the building official requires conformance to the CBC or CRC, the following shall be substituted:

2.2.1 Underlayment shall conform with CBC Section 1507.1.1 or CRC Section 905.1.1.

2.2.2 Attachment of the concrete roof tiles shall be designed to resist wind loads according to CBC Sections 1507.3.7 and 1609.5 or CRC Section 905.3, as applicable.

2.3 Boral Roofing concrete roof tiles may be used in "new buildings located in any Fire Hazard Severity Zone or any Wildland-Urban Interface Fire Area designated by the enforcing agency constructed after the application date shall comply with the provisions" in accordance with Sections 701A.3 and 705A of the CBC, or Sections R37.1.3.1 and R37.5 of the CRC, as applicable, and with the IBC as presented in ER-412.

EVALUATION REPORT

Number: **412**


Originally Issued: 07/31/2015 Revised: 03/29/2020 Valid Through: 07/31/2021

FLORIDA SUPPLEMENT

PATTERN



COLOR

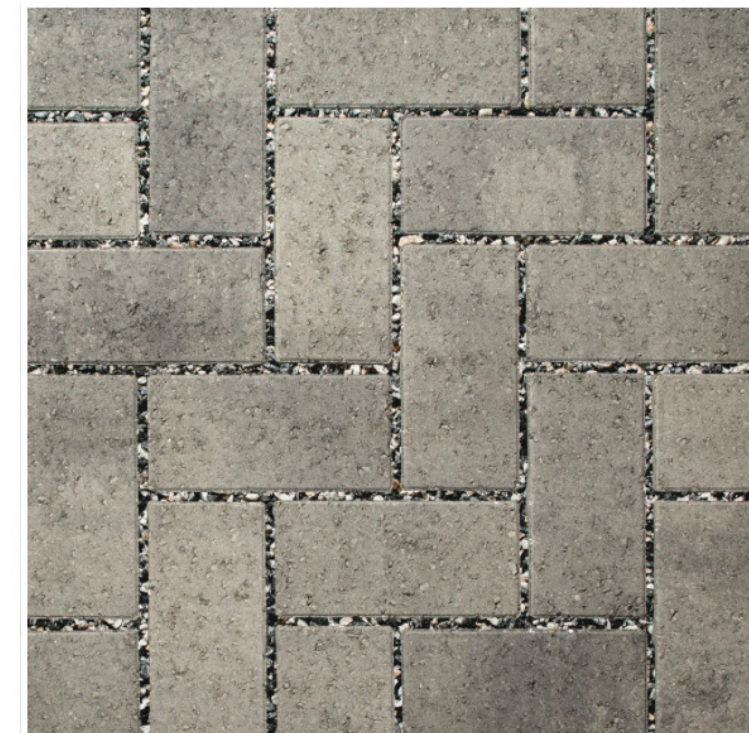


BELGARD® PAVES THE WAY
BELGARD.COM | 877-235-4273

AQUA DUBLIN
3-PIECE MECHANICAL PATTERN

NOTES:
AutoCAD® hatch pattern files can be downloaded from belgard.com for use in architectural drawings.
Some patterns may not necessarily reflect the percentages of stone sizes within a particular pallet. In some cases you may have extras in one or more of the sizes. This must be accounted for in your planning and design.
Percentages are based on area by paver.

21% 3 1/2" x 6 1/4" Rectangles
23% 6 1/4" x 6 1/4" Squares
56% 10" x 6 1/4" Rectangles

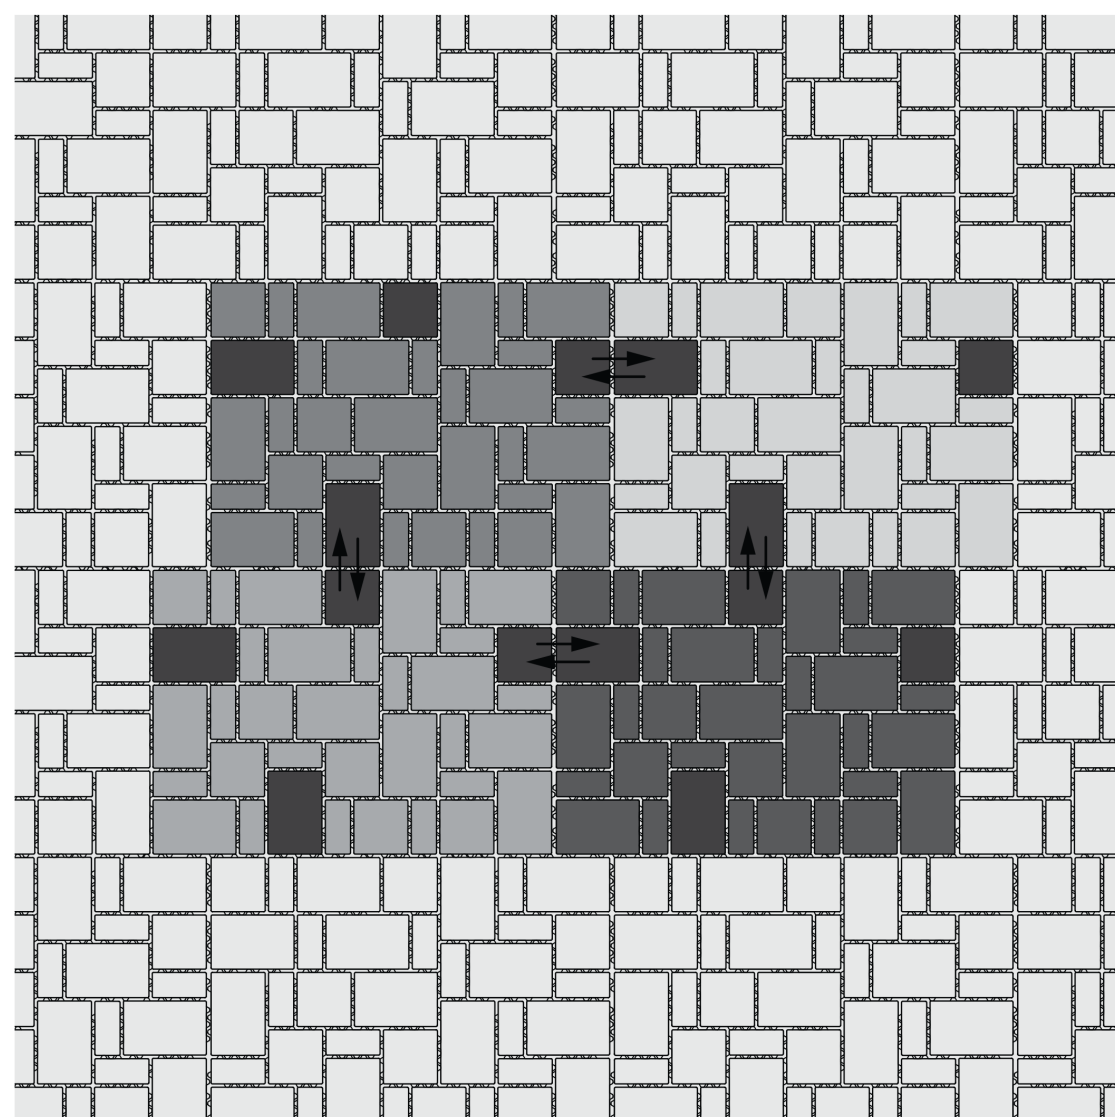

LAST REV: 07/15/21
BELGARD RESOURCE CENTER | BELGARD.COM | 877-235-4273

63

ICC-ES Report
ICC-ES | (800) 423-6587 | (562) 699-0543 | www.icc-es.org

Most Widely Accepted and Trusted

ESR-3500
Revised 01/2017
This report is subject to renewal 03/2018.

DIVISION: 07 00 00—THERMAL AND MOISTURE PROTECTION
SECTION: 07 21 00—THERMAL INSULATION

ICYNENE INSULATION

REPORT HOLDER:
ICYNENE, INC.
6747 CAMPOBELLO ROAD
MISSISSAUGA, ONTARIO L5N 2L7
CANADA
www.icynene.com
info@icynene.com

EVALUATION SUBJECT:
ICYNENE PROSEAL AND ICYNENE PROSEAL LE

1.0 EVALUATION SCOPE

1.1 Compliance with the following codes:

- 2015, 2012 and 2009 International Building Code® (IBC)
- 2015, 2012 and 2009 International Residential Code® (IRC)
- 2015, 2012 and 2009 International Energy Conservation Code (IECC)

Properties evaluated:

- Surface-burning characteristics
- Physical properties
- Thermal resistance (R-values)
- Attic and crawl-space installation
- Air permeability
- Vapor permeability
- Fire-resistance-rated construction
- Water-resistive barrier
- Exterior walls of Types I–IV construction

1.2 Evaluation to the following green building standard:

- 2008 ICC 700 National Green Building Standard™ (ICC 700-2008)

Attributes verified:

- See Section 3.1

ICC-ES Evaluation Reports are not to be construed as representing aesthetics or any other attributes not specifically addressed, nor are they to be construed as an endorsement of the subject of the report or a recommendation for its use. There is no warranty by ICC Evaluation Service, LLC, express or implied, as to any finding or other matter in this report, or as to any product covered by the report.

Copyright © 2017 ICC Evaluation Service, LLC. All rights reserved.

ICC-ES Report
ICC-ES | (800) 423-6587 | (562) 699-0543

Most Widely Accepted and Trusted

ESR-3500
Revised January 2017
This report is subject to renewal January 2018.

DIVISION: 07 00 00—THERMAL AND MOISTURE PROTECTION
SECTION: 07 21 00—Thermal Insulation

REPORT HOLDER:
ICYNENE, INC.
6747 CAMPOBELLO ROAD
MISSISSAUGA, ONTARIO L5N 2L7
CANADA
www.icynene.com
info@icynene.com

EVALUATION SUBJECT:
ICYNENE PROSEAL AND ICYNENE PROSEAL LE

1.0 EVALUATION SCOPE

1.1 Compliance with the following codes:

- 2015, 2012 and 2009 International Building Code® (IBC)
- 2015, 2012 and 2009 International Residential Code® (IRC)
- 2015, 2012 and 2009 International Energy Conservation Code (IECC)

Properties evaluated:

- Surface-burning characteristics
- Physical properties
- Thermal resistance (R-values)
- Attic and crawl-space installation
- Air permeability
- Vapor permeability
- Fire-resistance-rated construction
- Water-resistive barrier
- Exterior walls of Types I–IV construction

1.2 Evaluation to the following green building standard:

- 2008 ICC 700 National Green Building Standard™ (ICC 700-2008)

Attributes verified:

- See Section 3.1

ICC-ES Evaluation Reports are not to be construed as representing aesthetics or any other attributes not specifically addressed, nor are they to be construed as an endorsement of the subject of the report or a recommendation for its use. There is no warranty by ICC Evaluation Service, LLC, express or implied, as to any finding or other matter in this report, or as to any product covered by the report.

Copyright © 2017 ICC Evaluation Service, LLC. All rights reserved.

ICC-ES Report
ICC-ES | (800) 423-6587 | (562) 699-0543

Most Widely Accepted and Trusted

ESR-3500
Revised January 2017
This report is subject to renewal January 2018.

DIVISION: 07 00 00—THERMAL AND MOISTURE PROTECTION
SECTION: 07 21 00—Thermal Insulation

REPORT HOLDER:
ICYNENE, INC.
6747 CAMPOBELLO ROAD
MISSISSAUGA, ONTARIO L5N 2L7
CANADA
www.icynene.com
info@icynene.com

EVALUATION SUBJECT:
ICYNENE PROSEAL AND ICYNENE PROSEAL LE

1.0 EVALUATION SCOPE

1.1 Compliance with the following codes:

- 2015, 2012 and 2009 International Building Code® (IBC)
- 2015, 2012 and 2009 International Residential Code® (IRC)
- 2015, 2012 and 2009 International Energy Conservation Code (IECC)

Properties evaluated:

- Surface-burning characteristics
- Physical properties
- Thermal resistance (R-values)
- Attic and crawl-space installation
- Air permeability
- Vapor permeability
- Fire-resistance-rated construction
- Water-resistive barrier
- Exterior walls of Types I–IV construction

1.2 Evaluation to the following green building standard:

- 2008 ICC 700 National Green Building Standard™ (ICC 700-2008)

Attributes verified:

- See Section 3.1

ICC-ES Evaluation Reports are not to be construed as representing aesthetics or any other attributes not specifically addressed, nor are they to be construed as an endorsement of the subject of the report or a recommendation for its use. There is no warranty by ICC Evaluation Service, LLC, express or implied, as to any finding or other matter in this report, or as to any product covered by the report.

Copyright © 2017 ICC Evaluation Service, LLC. All rights reserved.

COPYRIGHT,
2017 BY THOMAS OCHSNER.
ALL RIGHTS RESERVED.
NO PART OF THIS DRAWING MAY
BE REPRODUCED.

THOMAS OCHSNER
Architect

ARCHITECTURE & PLANNING

Thomas Ochsner AIA Architect

1847 State Street
Santa Barbara, CA 93101
Tel 805.770.7576
Cel 805.705.6558
tom@toarchitect.com
www.toarchitect.com

CLIENT

Emilio Ruggiero

PROJECT

DETACHED ACCESSORY DWELLING UNIT

1308 CACIQUE ST, SANTA BARBARA, CA, 93101

SHEET TITLE

TESTING REPORTS

REVISIONS

PROJECT NAME: DETACHED ACCESSORY DWELLING UNIT

DATE DRAWN:

DATE: 12/28/20

SHEET NO.:

T-1.5

ICC-ES Report
ICC-ES | (800) 423-6587 | (562) 699-0543

Most Widely Accepted and Trusted

ESR-3500
Revised January 2017
This report is subject to renewal January 2018.

DIVISION: 07 00 00—THERMAL AND MOISTURE PROTECTION
SECTION: 07 21 00—Thermal Insulation

REPORT HOLDER:
ICYNENE, INC.
6747 CAMPOBELLO ROAD
MISSISSAUGA, ONTARIO L5N 2L7
CANADA
www.icynene.com
info@icynene.com

EVALUATION SUBJECT:
ICYNENE PROSEAL AND ICYNENE PROSEAL LE

1.0 EVALUATION SCOPE

1.1 Compliance with the following codes:

- 2015, 2012 and 2009 International Building Code® (IBC)
- 2015, 2012 and 2009 International Residential Code® (IRC)
- 2015, 2012 and 2009 International Energy Conservation Code (IECC)

Properties evaluated:

- Surface-burning characteristics
- Physical properties
- Thermal resistance (R-values)
- Attic and crawl-space installation
- Air permeability
- Vapor permeability
- Fire-resistance-rated construction
- Water-resistive barrier
- Exterior walls of Types I–IV construction

1.2 Evaluation to the following green building standard:

- 2008 ICC 700 National Green Building Standard™ (ICC 700-2008)

Attributes verified:

- See Section 3.1

ICC-ES Evaluation Reports are not to be construed as representing aesthetics or any other attributes not specifically addressed, nor are they to be construed as an endorsement of the subject of the report or a recommendation for its use. There is no warranty by ICC Evaluation Service, LLC, express or implied, as to any finding or other matter in this report, or as to any product covered by the report.

Copyright © 2017 ICC Evaluation Service, LLC. All rights reserved.

TABLE 1—THERMAL RESISTANCE (R-VALUES)

THICKNESS (inches)	R-VALUE (Ft ² ·h/Btu)
1.0	7.1
3.5	24
4.0	28
5.5	38
6.0	42
7.5	52
9.5	66
10.0	69
11.25	78

For 8 1/2 inch=24.4 mm; 1" F R' hBtu = 0.178110°K/m²·h/W
R-values are calculated based on tested R-values at 1" and 3.5-inch thicknesses.

TABLE 2—NFPA 285 COMPLYING EXTERIOR WALL ASSEMBLIES

THICKNESS (inches)	R-VALUE (Ft ² ·h/Btu)
1.0	7.1
3.5	24
4.0	28
5.5	38
6.0	42
7.5	52
9.5	66
10.0	69
11.25	78

ICC-ES Report
ICC-ES | (800) 423-6587 | (562) 699-0543

Most Widely Accepted and Trusted

ESR-3500
Revised January 2017
This report is subject to renewal January 2018.

DIVISION: 07 00 00—THERMAL AND MOISTURE PROTECTION
SECTION: 07 21 00—Thermal Insulation

REPORT HOLDER:
ICYNENE, INC.
6747 CAMPOBELLO ROAD
MISSISSAUGA, ONTARIO L5N 2L7
CANADA
www.icynene.com
info@icynene.com

EVALUATION SUBJECT:
ICYNENE PROSEAL AND ICYNENE PROSEAL LE

1.0 EVALUATION SCOPE

1.1 Compliance with the following codes:

- 2015, 2012 and 2009 International Building Code® (IBC)
- 2015, 2012 and 2009 International Residential Code® (IRC)
- 2015, 2012 and 2009 International Energy Conservation Code (IECC)

Properties evaluated:

- Surface-burning characteristics
- Physical properties
- Thermal resistance (R-values)
- Attic and crawl-space installation
- Air permeability
- Vapor permeability
- Fire-resistance-rated construction
- Water-resistive barrier
- Exterior walls of Types I–IV construction

1.2 Evaluation to the following green building standard:

- 2008 ICC 700 National Green Building Standard™ (ICC 700-2008)

Attributes verified:

- See Section 3.1

ICC-ES Evaluation Reports are not to be construed as representing aesthetics or any other attributes not specifically addressed, nor are they to be construed as an endorsement of the subject of the report or a recommendation for its use. There is no warranty by ICC Evaluation Service, LLC, express or implied, as to any finding or other matter in this report, or as to any product covered by the report.

Copyright © 2017 ICC Evaluation Service, LLC. All rights reserved.

TABLE 1—THERMAL RESISTANCE (R-VALUES)

THICKNESS (inches)	R-VALUE (Ft ² ·h/Btu)
1.0	7.1
3.5	24
4.0	28
5.5	38
6.0	42
7.5	52
9.5	66
10.0	69
11.25	78

For 8 1/2 inch=24.4 mm; 1" F R' hBtu = 0.178110°K/m²·h/W
R-values are calculated based on tested R-values at 1" and 3.5-inch thicknesses.

TABLE 2—NFPA 285 COMPLYING EXTERIOR WALL ASSEMBLIES

THICKNESS (inches)	R-VALUE (Ft ² ·h/Btu)
1.0	7.1
3.5	24
4.0	28
5.5	38
6.0	42
7.5	52
9.5	66
10.0	69
11.25	78



PROJECT NAME: DETACHED ACCESSORY DWELLING UNIT


DATE DRAWN:

DATE: 12/28/20

SHEET NO.:

T-1.5

S:\All Jobs\2021 All Jobs\21855 - 1308 Cacique (Civil) - Ochrane\02_Working Drawings\00-DD\02_ONSITE\2 GRADING SHEET.dwg, C-2.1, Feb 10, 2022 3:03pm, Email

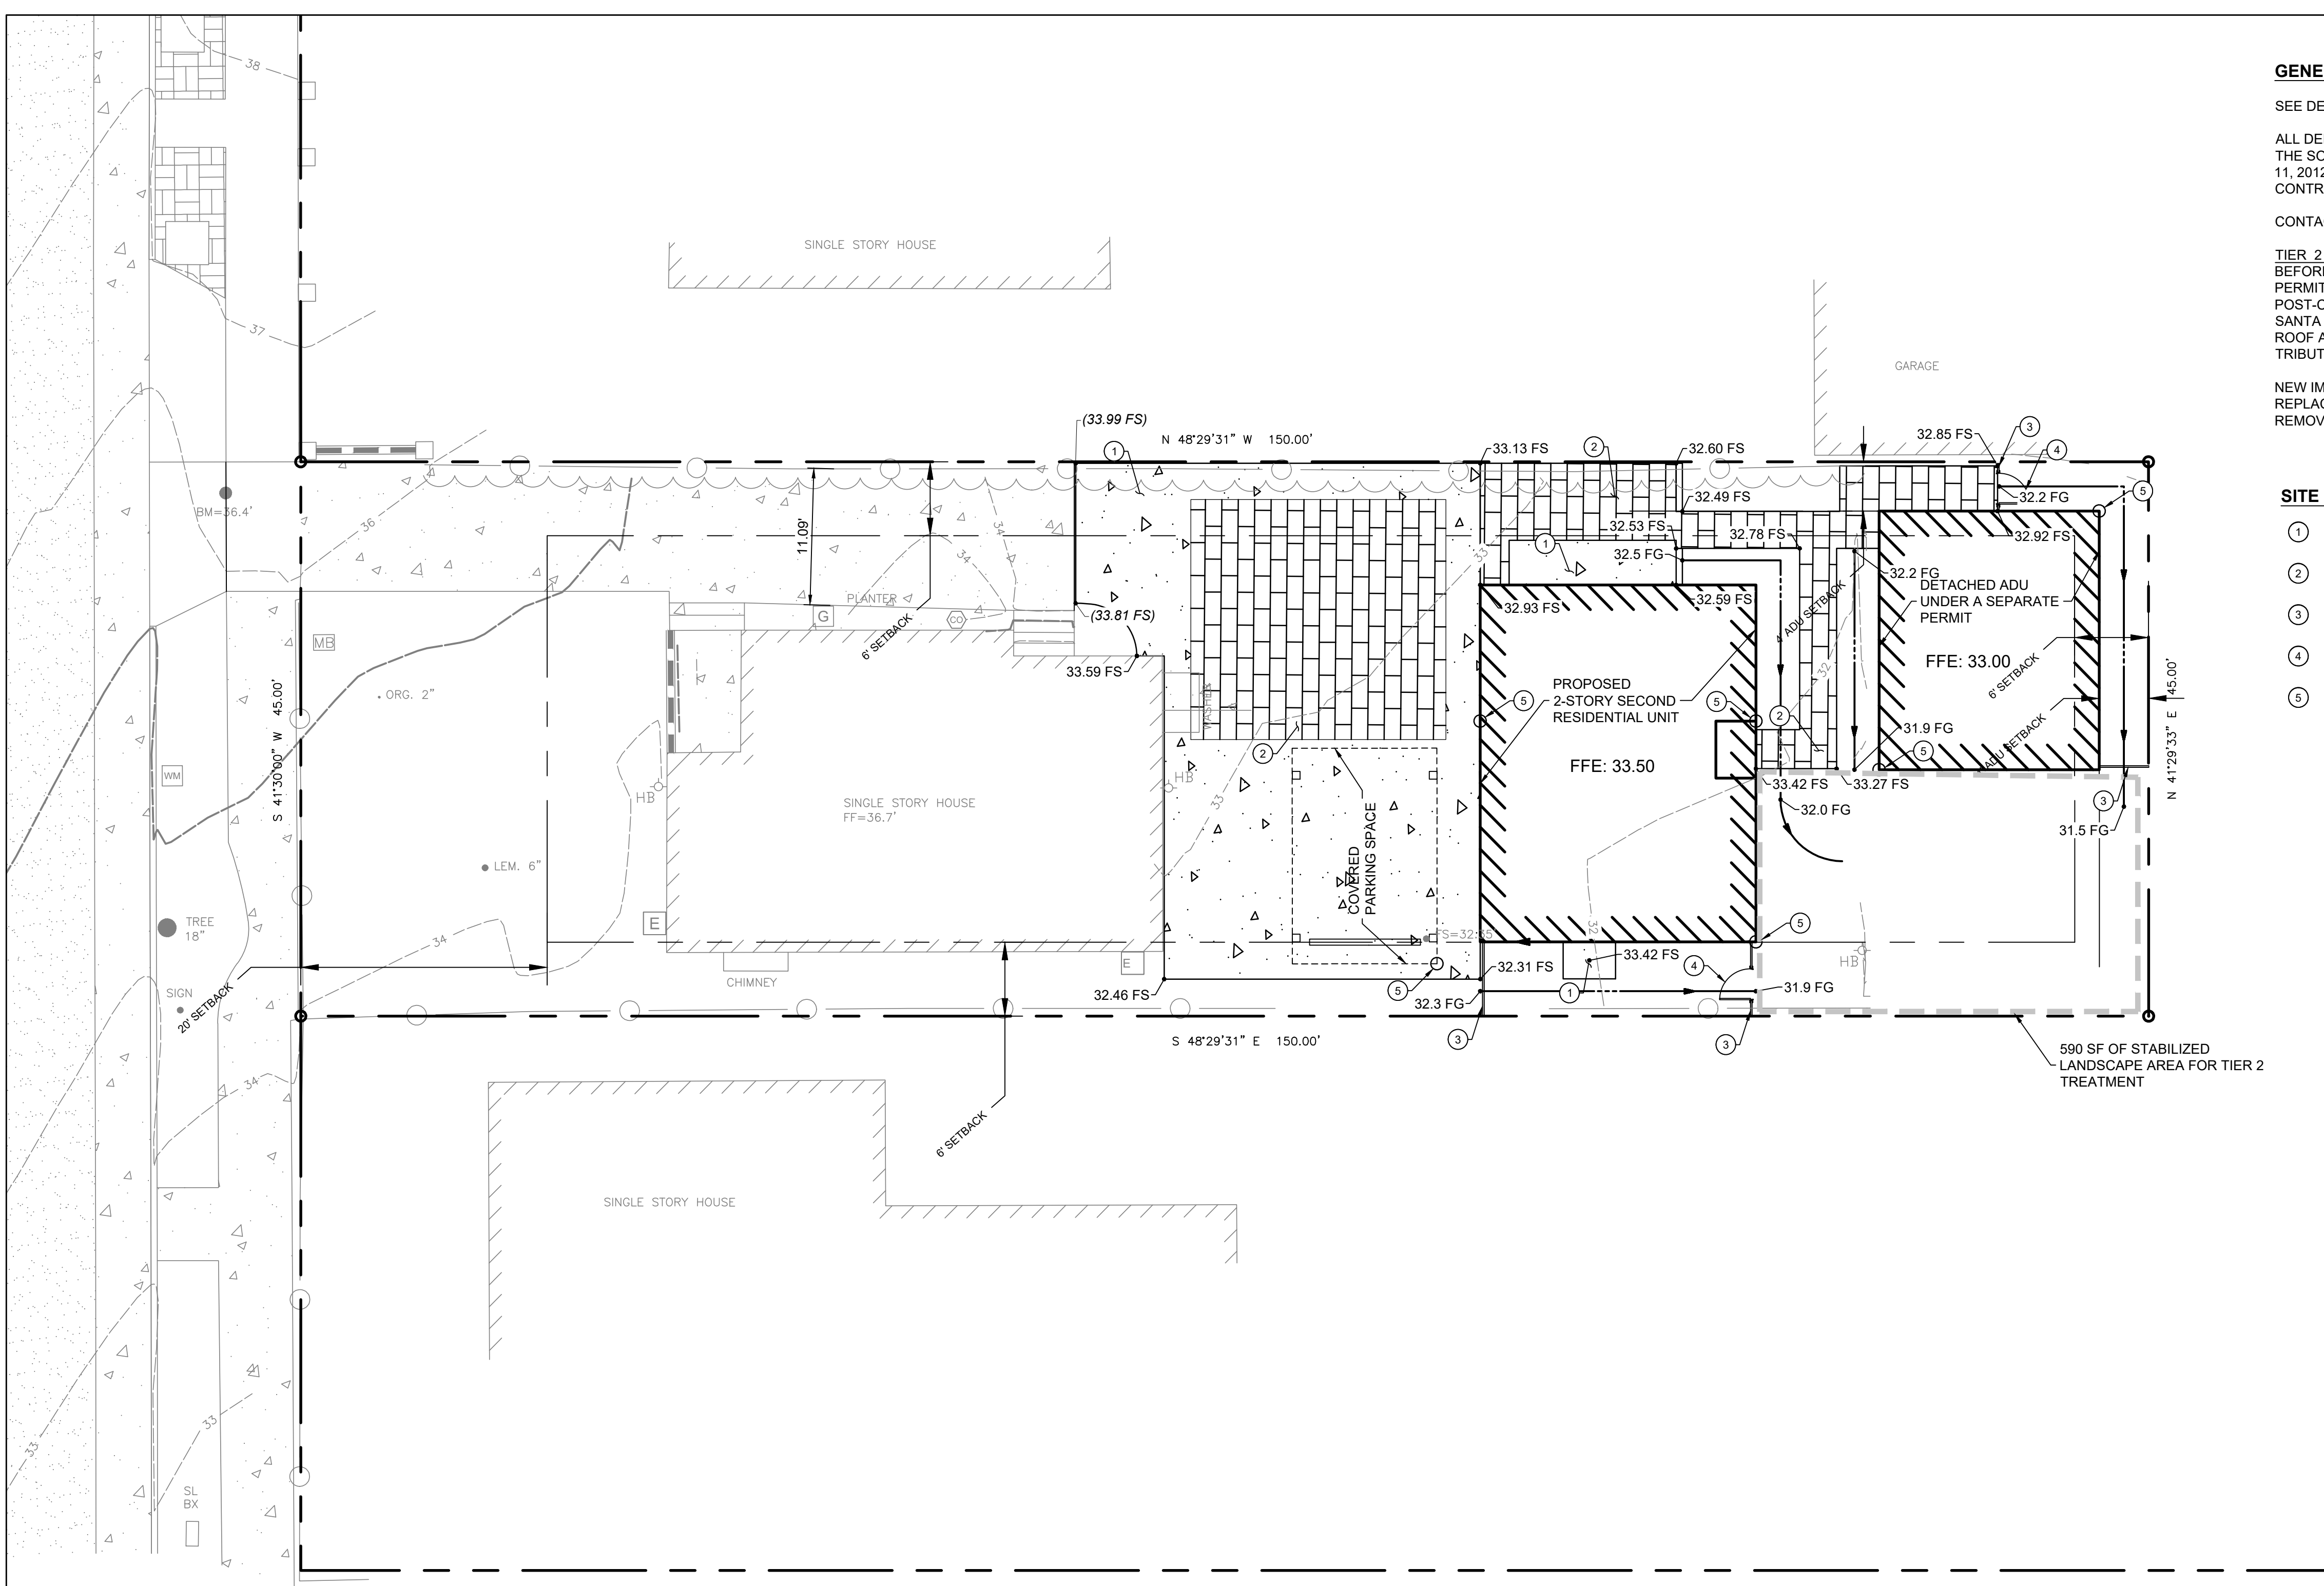

GENERAL NOTES:

SEE DEMOLITION AND PROTECTION PLAN FOR ADDITIONAL INFORMATION.

ALL DEMOLITION AND GRADING SHALL BE IN COMPLIANCE WITH THE RECOMMENDATIONS CONTAINED IN THE SOILS REPORT PREPARED BY HEATHCOTE GEOTECHNICAL, JOB NUMBER 21092, DATED SEPTEMBER 11, 2012 AND ALL ADDENDA TO THE REPORT SHALL BE CONSIDERED PART OF THESE PLANS. CONTRACTOR SHALL CONTACT SOILS ENGINEER PRIOR TO START OF DEMOLITION WORK.


CONTACT: FRED HEATHCOTE, PE PHONE: (805) 644-9978

TIER 2 BMP COMPLIANCE REQUIREMENT:
BEFORE THE BUILDING INSPECTOR WILL GRANT CERTIFICATE OF OCCUPANCY AND FINALIZE THE BUILDING PERMIT, THE CONTRACTOR IS TO HAVE THE BUILDING AND SAFETY DIVISION CERTIFY POST-CONSTRUCTION BMP'S WERE INSTALLED AS APPROVED AND THAT THEY COMPLY WITH THE CITY OF SANTA BARBARA'S TIER 2 STORM WATER REQUIREMENTS. UNLESS OTHERWISE NOTED, ALL IMPERVIOUS ROOF AND PAVEMENT AREAS WILL BE DIRECTED TO NATURAL/VEGETATED AREAS AT 25% OF THE TRIBUTARY AREA.



NEW IMPERVIOUS: 707 SF
REPLACED IMPERVIOUS: 1,132 SF
REMOVED IMPERVIOUS: 1,355 SF

SITE CONSTRUCTION NOTES:

- ① CONSTRUCT CONCRETE DRIVEWAY SECTION.
- ② CONSTRUCT PERMEABLE PAVER SECTION PER DETAIL 1, THIS SHEET.
- ③ CONSTRUCT FENCE PER ARCHITECT.
- ④ CONSTRUCT GATE PER ARCHITECT.
- ⑤ CONSTRUCT ROOF DOWNSPOUT WITH SPLASH BLOCK.

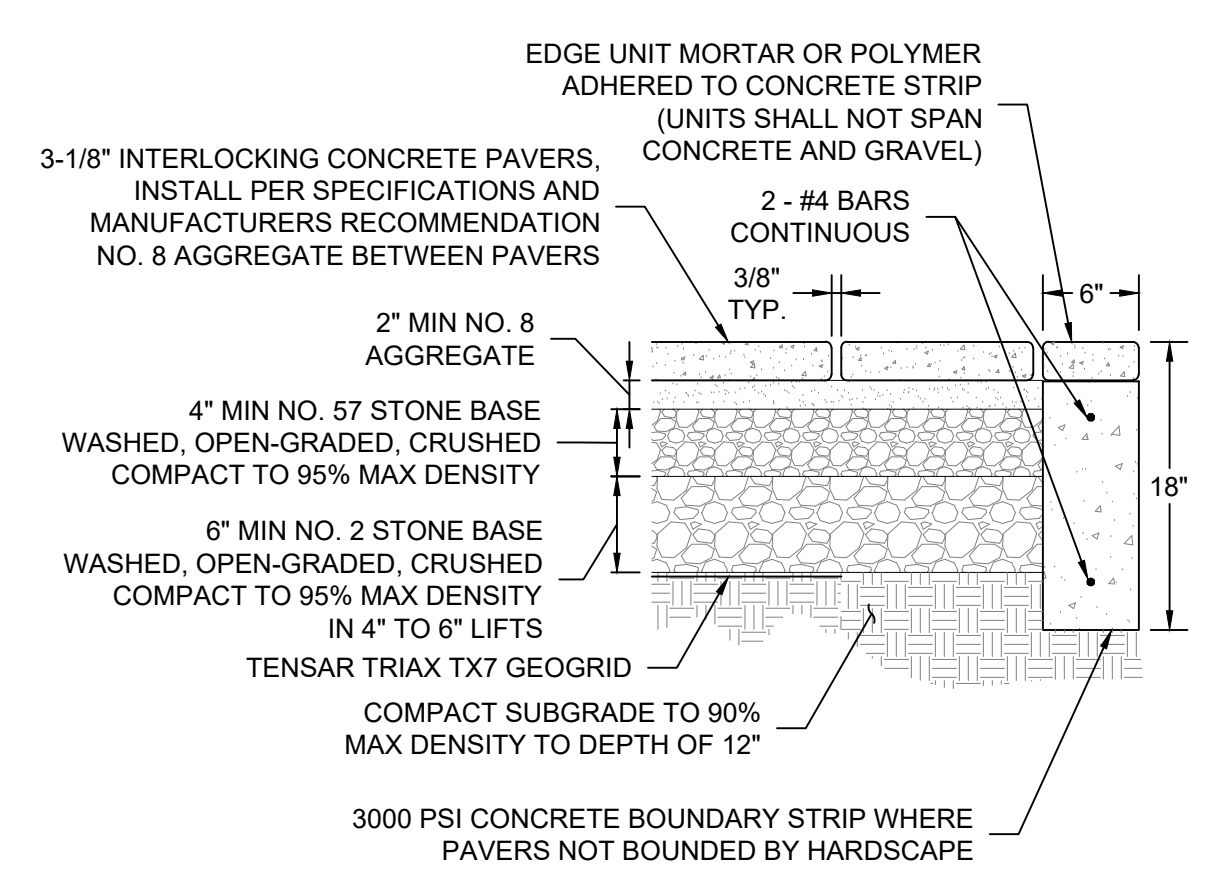

① PERMEABLE PAVER WALKWAY SECTION NTS

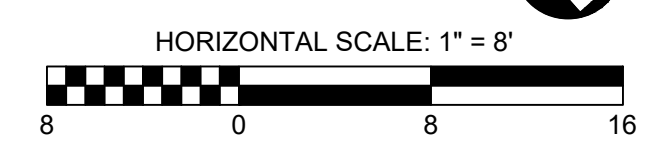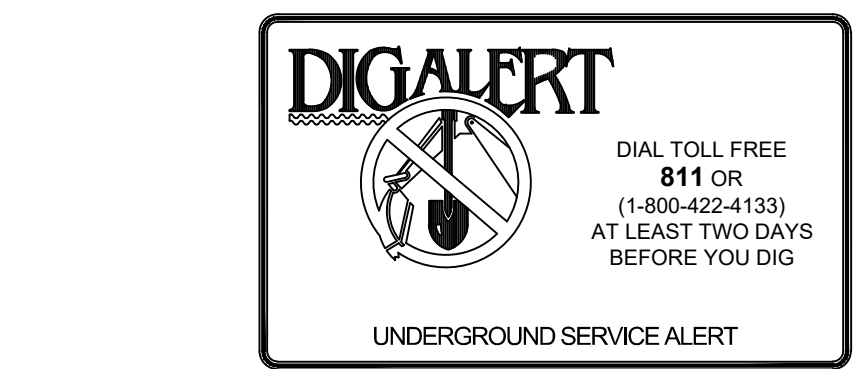

Plan Prepared By:
Ashley & Vance
 ENGINEERING, INC.
 CIVIL • STRUCTURAL
 1413 Monterey Street
 San Luis Obispo, CA 93401
 (805) 545-0010
 www.ashleyvance.com

The use of these plans and specifications shall be restricted to the original site for which they were prepared and publication thereof is expressly limited to such use. Reproduction or publication by any method, in whole or in part, is prohibited. Title to these plans and specifications remain with Ashley & Vance Engineering, Inc. without prejudice. Visual contact with these plans and specifications shall constitute prima facie evidence of the acceptance of these restrictions.

DETACHED ACCESSORY DWELLING UNIT
 1308 CACIQUE STREET
 SANTA BARBARA, CA 93103

Revisions:

①	
②	
③	
④	
⑤	

Project Engineer: ECR Ext: 152
Project Manager: JJG
Date: 02.10.2022 Scale: PER PLAN
AV Job No: 21985 Sheet Size: 24" x 36"

GRADING AND DRAINAGE PLAN
C-2.1



THOMAS OCHSNER
Architect

ARCHITECTURE & PLANNING

Thomas
Ochsner AIA
Architect

1847 State Street
Santa Barbara, CA 93101
Tel 805.770.7576
Cel 805.705.6558
tom@toarchitect.com
www.toarchitect.com

CLIENT

Emilio Ruggiero

PROJECT

DETACHED
ACCESSORY
DWELLING UNIT

1308 CACIQUE ST, SANTA
BARBARA, CA, 93101

SHEET TITLE

SITE PLAN

REVISIONS

Date: Revision: 2



PROJECT NAME DETACHED ACCESSORY DWELLING UNIT

DATE DRAWN

DATE 12/21/2020

SHEET NO.

A-1.0

STORMWATER KEYNOTES

- 01 4" STAMPED CONCRETE
- 02 IMPERVIOUS PAVERS
- 03 FILTER FENCE

STORMWATER CONTROL NOTES

1. CONTRACTOR SHALL SCHEDULE STORM DRAIN WORK AHEAD OF OTHER UNDERGROUND CONDUIT CONSTRUCTION.
2. GRAVITY STORM DRAIN WORK SHALL BEGIN AT THE LOWEST POINT OF DISCHARGE AND PROCEED UPSTREAM.
3. POLYVINYL CHLORIDE (PVC) PIPE FOR 4" THROUGH 15" SIZE SHALL COMPLY WITH THE MOST RECENT ISSUE OF ASTM STANDARD D-3034 (SDR 35). PVC PIPE SHALL HAVE AN INTEGRALLY MOLDED BELL OR SOCKET END FOR GASKETED JOINT ASSEMBLY. JOINTS AND GASKETS SHALL COMPLY WITH THE MOST RECENT ISSUE OF ASTM STANDARD D-3212 AND F-477, RESPECTIVELY. PVC PIPE INSTALLATION SHALL COMPLY WITH UNI-BELL PLASTIC PIPE ASSOCIATION STANDARD UNI-B-5, LATEST REVISION. PVC PIPE CONNECTIONS TO MANHOLES, CATCH BASINS AND OTHER CONCRETE STRUCTURES SHALL BE CONSTRUCTED WITH WATERSTOP AT MIDPOINT OF STRUCTURE WALL PENETRATION. WATERSTOP SHALL BE PVC CONCRETE MANHOLE ADAPTER (4" THROUGH 12" PIPE) OR LARGE DIAMETER WATERSTOP AS MANUFACTURED BY FERROCO, OR EQUIVALENT APPROVED BY THE ENGINEER.
4. HIGH DENSITY POLYETHYLENE (HDPE) PIPE AND FITTINGS FOR 4" THROUGH 48" SIZE SHALL BE N-12PROLINK WT (WATERTIGHT) SERIES AS MANUFACTURED BY ADVANCED DRAINAGE SYSTEMS, INC. (ADS), UNLESS NOTED OTHERWISE. LATERAL CONNECTIONS TO MANLINES SHALL BE MADE USING MANUFACTURER'S WATERTIGHT REDUCING FITTINGS. PIPE AND FITTING INSTALLATION SHALL BE IN ACCORDANCE WITH MANUFACTURER'S RECOMMENDED PROCEDURES. CONNECTIONS TO CONCRETE STRUCTURES SHALL BE CONSTRUCTED WATERTIGHT USING MANUFACTURER'S RECOMMENDED MATERIALS AND METHODS.
5. GRATED CATCH BASINS SHALL BE CONSTRUCTED IN ACCORDANCE WITH THE PLAN DETAIL QUALITY REVIEW AND REPORTING MEASUREMENTS.
 - A. CONTRACTOR SHALL REQUEST INSPECTION BY ENGINEER OF WORK AFTER INSTALLATION AND ASSEMBLY OF STORM DRAINAGE PIPING, BUT BEFORE COVERING.
 - B. CONTRACTOR SHALL REQUEST INSPECTION BY ENGINEER OF WORK AFTER FORMING AND PLACING REINFORCING STEEL FOR CAST-IN-PLACE DRAINAGE STRUCTURES, BUT BEFORE SCHEDULING THE CONCRETE POUR.
 - C. WITHIN TEN (10) WORKING DAYS OF COMPLETION OF THE STORM DRAIN SYSTEM AND BEFORE CONSTRUCTION OF PAVEMENT, WALKWAYS AND OTHER PERMANENT SURFACE IMPROVEMENTS, CONTRACTOR SHALL PROVIDE A CONSTRUCTION RECORD DRAWING OF THE SYSTEM TO INCLUDE TOP OF GRATE OR COVER AND INLET AND OUTLET INVERT ELEVATIONS OF ALL STORM DRAIN STRUCTURES. ELEVATION MEASUREMENTS SHALL BE ACCURATE TO 0.01 FEET.
 - D. UPON COMPLETION OF CONSTRUCTION OF THE STORM DRAIN SYSTEM AND WITH 48 HOURS NOTICE TO ENGINEER OF WORK, CONTRACTOR SHALL THOROUGHLY CLEAN AND WASH DOWN ALL INLETS AND STORM DRAIN PIPING USING FIRE HYDRANT FLOWS.

GRADING NOTES


1. SEE PLUMBING, MECHANICAL AND ELECTRICAL PLANS FOR PROPOSED UTILITY SERVICE SIZES AND SPECIFICATIONS
2. CONTRACTOR TO CONFIRM SIZE, LOCATION AND CONDITION OF EXISTING UTILITY SERVICES PRIOR TO CONDUCT UTILITY SERVICES
3. EXISTING UTILITY LOCATIONS ARE COMPLETED FROM RECORD INFORMATION AND ARE APPROXIMATE
4. ALL DEMOLITION AND GRADING SHALL BE IN COMPLIANCE WITH THE RECOMMENDATIONS CONTAINED IN THE SOILS REPORT. CONTRACTOR SHALL CONTACT SOILS ENGINEER PRIOR TO START OF DEMOLITION WORK.

ARBORIST NOTES


1. TREE PROTECTION FENCING IS TO BE INSTALLED USING 6" STEEL POSTS ALONG A LINE PARALLELING THE DRIVEWAY FROM ITS BEGINNING AT THE SOUTH END, PASSING BY THE PARKING AREA, AND ON UP TO THE PROPERTY LINE AS SHOWN IN THE PLAN SECTION ON PAGE 4, EVEN THOUGH THE CRITICAL ROOT ZONES OF TWO TREES ARE NOT SHOWN IN THE NORTHEAST PROPERTY CORNER. FENCING MUST EXCLUDE THIS AREA FROM CONSTRUCTION ACTIVITY.
2. FENCING IS TO BE INSTALLED FOR TREE #1 IN SUCH A WAY AS TO ALLOW FOR GRADING ACTIVITY WITHIN THE CRZ BUT PROVIDE ADEQUATE PROTECTION FOR THE TREE.
3. THE TOTAL AREA TO THE EAST OF THE PROTECTION FENCING IS TO BE KEPT FREE OF VEHICLES AND STORED MATERIALS.
4. NO DITCHING FOR UTILITIES IS TO OCCUR IN THE AREA TO THE EAST OF THE PROTECTION FENCING UNLESS OVERSEEN BY THE PROJECT ARBORIST.
5. A PORTABLE CONCRETE AND PLASTER WASH OUT BASIN IS TO BE PLACED IN THE LOCATION NOTED IN THE PLAN SECTION ON PAGE 5.
6. ALL OAK TREE ROOTS EXPOSED WHICH ARE 2" IN DIAMETER AND LARGE ARE TO BE CUT EVEN TO HELP PREVENT DECAY.

GENERAL NOTES - DEMOLITION


1. THE INTENT OF THE DEMOLITION WORK IS TO COMPLETE REMOVALS NECESSARY IN ORDER TO CONSTRUCT THE NEW WORK. THE REMOVAL NOTES ARE GENERAL IN NATURE AND IT SHALL BE UNDERSTOOD THAT IT IS NOT FEASIBLE TO SHOW EACH AND EVERY SPECIFIC REMOVAL. DEMOLITION DRAWINGS SHOULD NOT BE USED ALONE BUT SHOULD BE USED IN CONJUNCTION WITH THE OTHER DRAWINGS. SEE STRUCTURAL DRAWINGS FOR CERTAIN ADDITIONAL WORK TO BE REMOVED, RE-USED, AND/OR REVISED NOT MENTIONED HERE. UNLESS OTHERWISE NOTED, THE SCOPE OF WORK OUTLINED BY DEMOLITION NOTES ARE THE RESPONSIBILITY OF THE GENERAL CONTRACTOR. PLEASE REFERENCE PROJECT GENERAL NOTES ON SHEET A0.00 PRIOR TO COMMENCEMENT OF DEMOLITION WORK.
2. STRUCTURAL ITEMS SHOWN AS TO BE REMOVED ARE FOR REFERENCE ONLY. VERIFY APPROPRIATE SHORING OR REINFORCEMENT CONDITION WITH STRUCTURAL DRAWINGS.
3. ARCHITECT IS NOT RESPONSIBLE FOR REMOVAL / ABATEMENT OF HAZARDOUS MATERIALS. CONTRACTOR TO PROVIDE REMOVAL / ABATEMENT AT LOCATIONS NECESSARY. IN THE EVENT TOXIC MATERIALS ARE UNCOVERED GENERAL CONTRACTOR IS TO NOTIFY HEALTH & SAFETY AGENCIES OF THE GOVERNING JURISDICTION.
4. DEMOLITION DRAWINGS SHOW REMOVALS IN GENERAL AND ARE BASED ON ORIGINAL DRAWINGS. THERE MAY HAVE BEEN CHANGES SINCE THAT DATE. CONTRACTORS SHALL VISIT PROJECT SITE TO BECOME FAMILIAR WITH COMPLETE SCOPE OF REMOVALS/DEMOLITIONS AND TO FIELD VERIFY CONDITIONS.
5. RESPECTIVE CONTRACTORS SHALL REMOVE PLUMBING, MECHANICAL, ELECTRICAL, OR MISCELLANEOUS AS REASONABLY INFERRED. CAP OR RECONNECT ALL EXISTING LINES AS REQUIRED.
6. CONTRACTOR FOR GENERAL WORK SHALL REMOVE REMAINING PLUMBING, MECHANICAL, ELECTRICAL OR MISCELLANEOUS ITEMS REQUIRED TO COMPLETE NEW WORK BUT NOT REQUIRED TO REMAIN SUCH AS PIPES AND CONDUITS IN WALLS THAT HAVE BEEN DISCONNECTED AND REMAINING PORTIONS CAPPED OR RECONNECTED.
7. THROUGHOUT DEMOLITION AND CONSTRUCTION, PROTECT ITEMS SCHEDULED TO REMAIN AND/OR ALL ADJACENT MATERIALS AND EQUIPMENT, ETC., INDICATED TO REMAIN. COORDINATE REMOVAL AND PROTECTIONS WITH OWNER.
8. DEMOLISHED MATERIAL OR ITEMS REMOVED AND NOT SCHEDULED TO BE TURNED OVER TO THE OWNER SHALL BE REMOVED FROM THE SITE.
9. GENERAL CONTRACTOR SHALL RECYCLE DEMOLITION CONSTRUCTION DEBRIS IN ACCORDANCE WITH NATIONAL, STATE, AND/OR LOCAL REQUIREMENTS, AS APPROPRIATE.

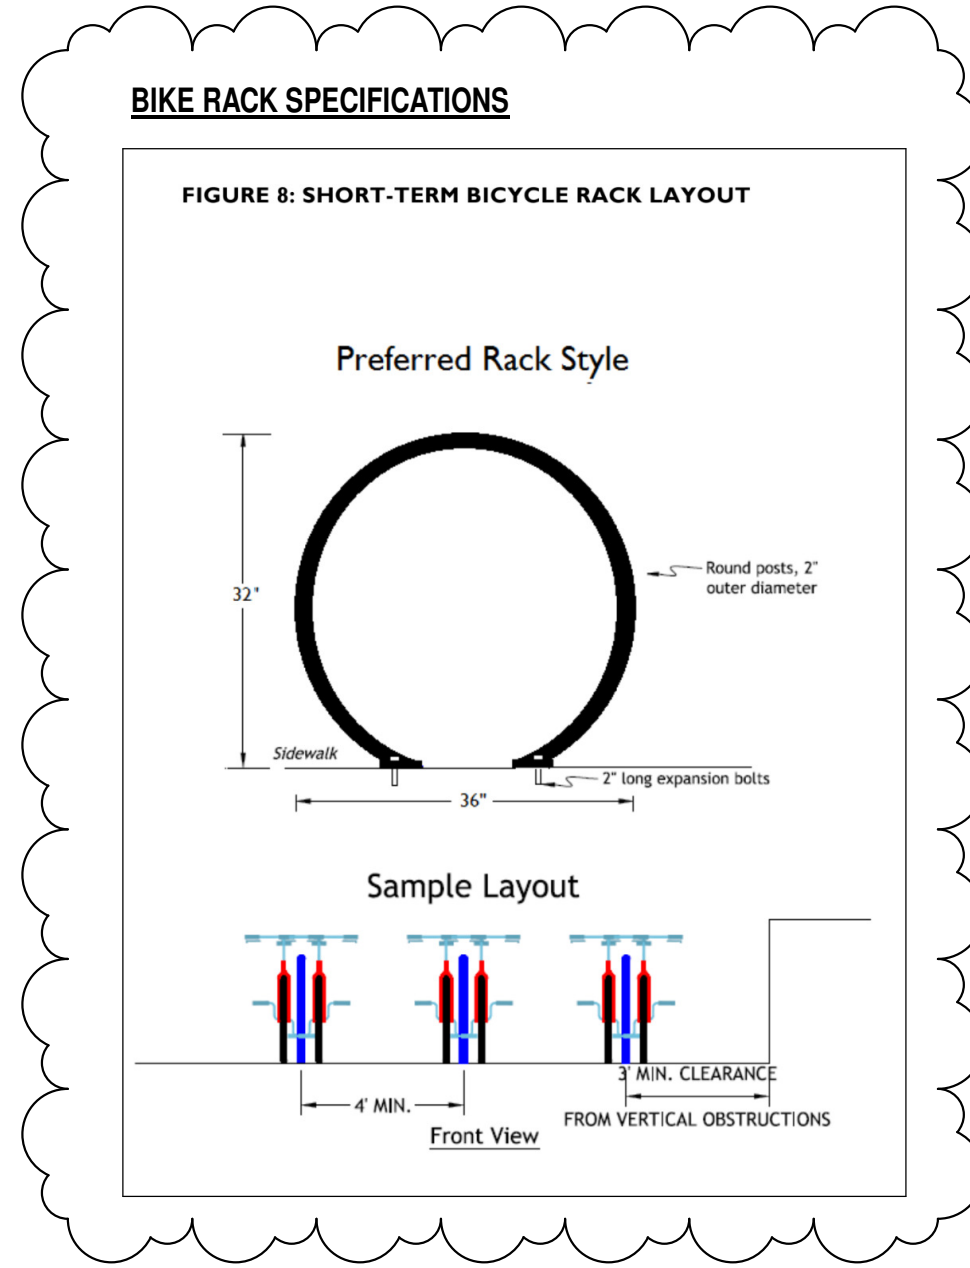

FIXED STEEL 2" DIAM MIN BIKE RACKS TO CONFORM TO TRANSPORTATION DEPT. STANDARDS FOR PARKING DESIGN SECTION 13 (PAGE 17). SEE ABOVE EXPERT FIGURE #8.

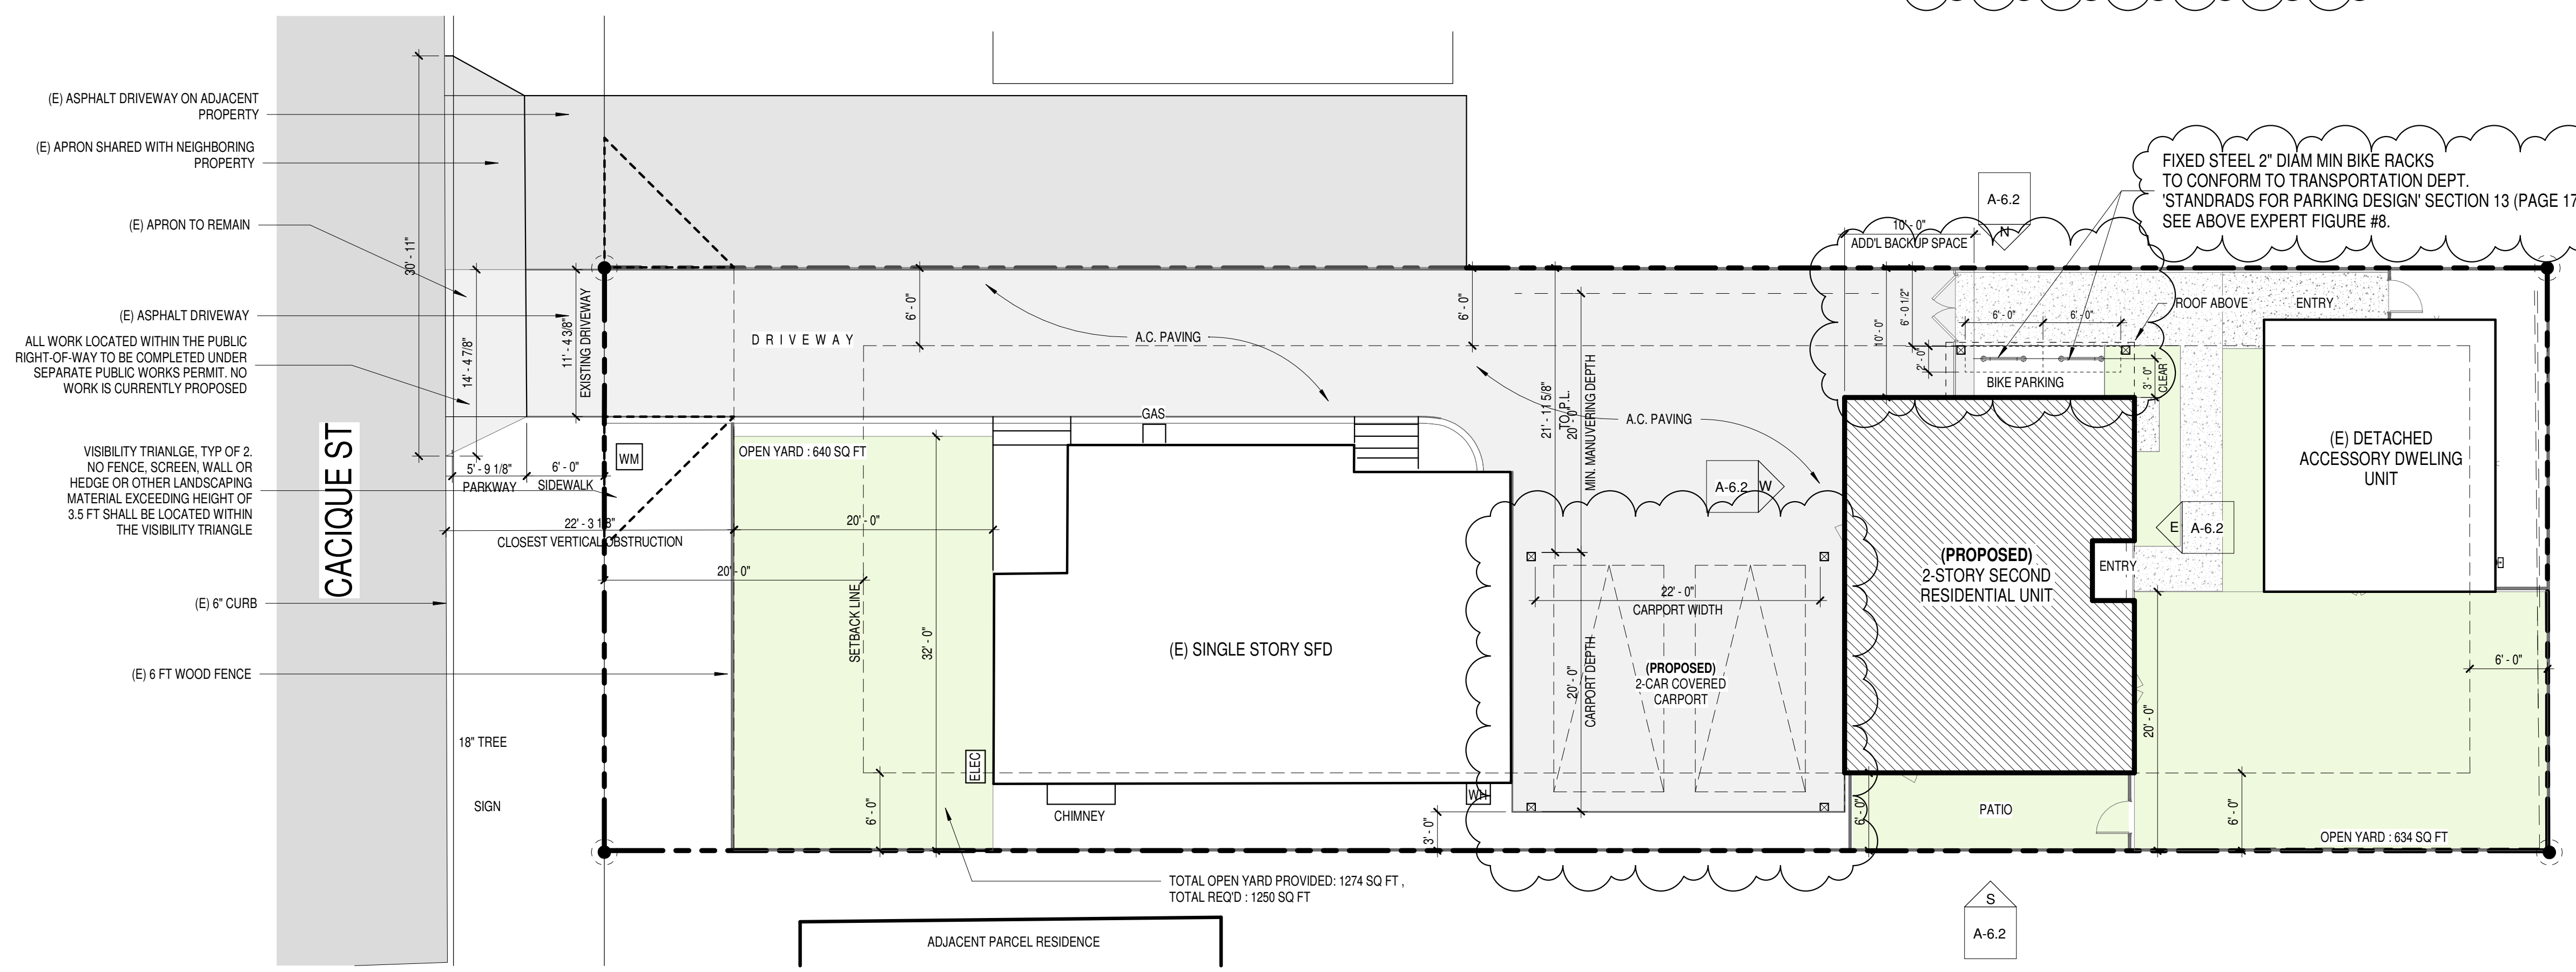

PROPOSED SITE PLAN 2
SCALE: 1/8" = 1'-0"

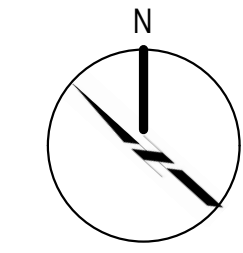



THOMAS OCHSNER
Architect

ARCHITECTURE & PLANNING

Thomas
Ochsner AIA
Architect

1847 State Street
Santa Barbara, CA 93101
Tel 805.770.7576
Cel 805.705.6558
tom@toarchitect.com
www.toarchitect.com

CLIENT

Emilio Ruggiero

PROJECT

DETACHED
ACCESSORY
DWELLING UNIT

1308 CACIQUE ST, SANTA
BARBARA, CA, 93101

SHEET TITLE

PROPOSED FLOOR
PLANS

REVISIONS



PROJECT NAME DETACHED ACCESSORY
DWELLING UNIT

DATE DRAWN

DATE 12/21/2020


SHEET NO.

GENERAL NOTES - FLOOR PLAN

1. HARDWIRED SMOKE DETECTORS W/ BATTERY BACK-UP ARE REQUIRED IN EA BEDROOM & IN AREAS LEADING TO BEDROOMS & AT TOP OF STAIRS.
2. ALL BEDROOMS REQUIRE AT LEAST ONE EGRESS WINDOW PER CBC SECTION 310.
3. GLAZING MUST CONFORM TO CBC SECTION 2406 WHERE APPLICABLE.
4. FURNITURE NOT IN CONTRACT.


KEYNOTES

KEY VALUE	KEYNOTE DESIGNATION
	KEYNOTE TEXT

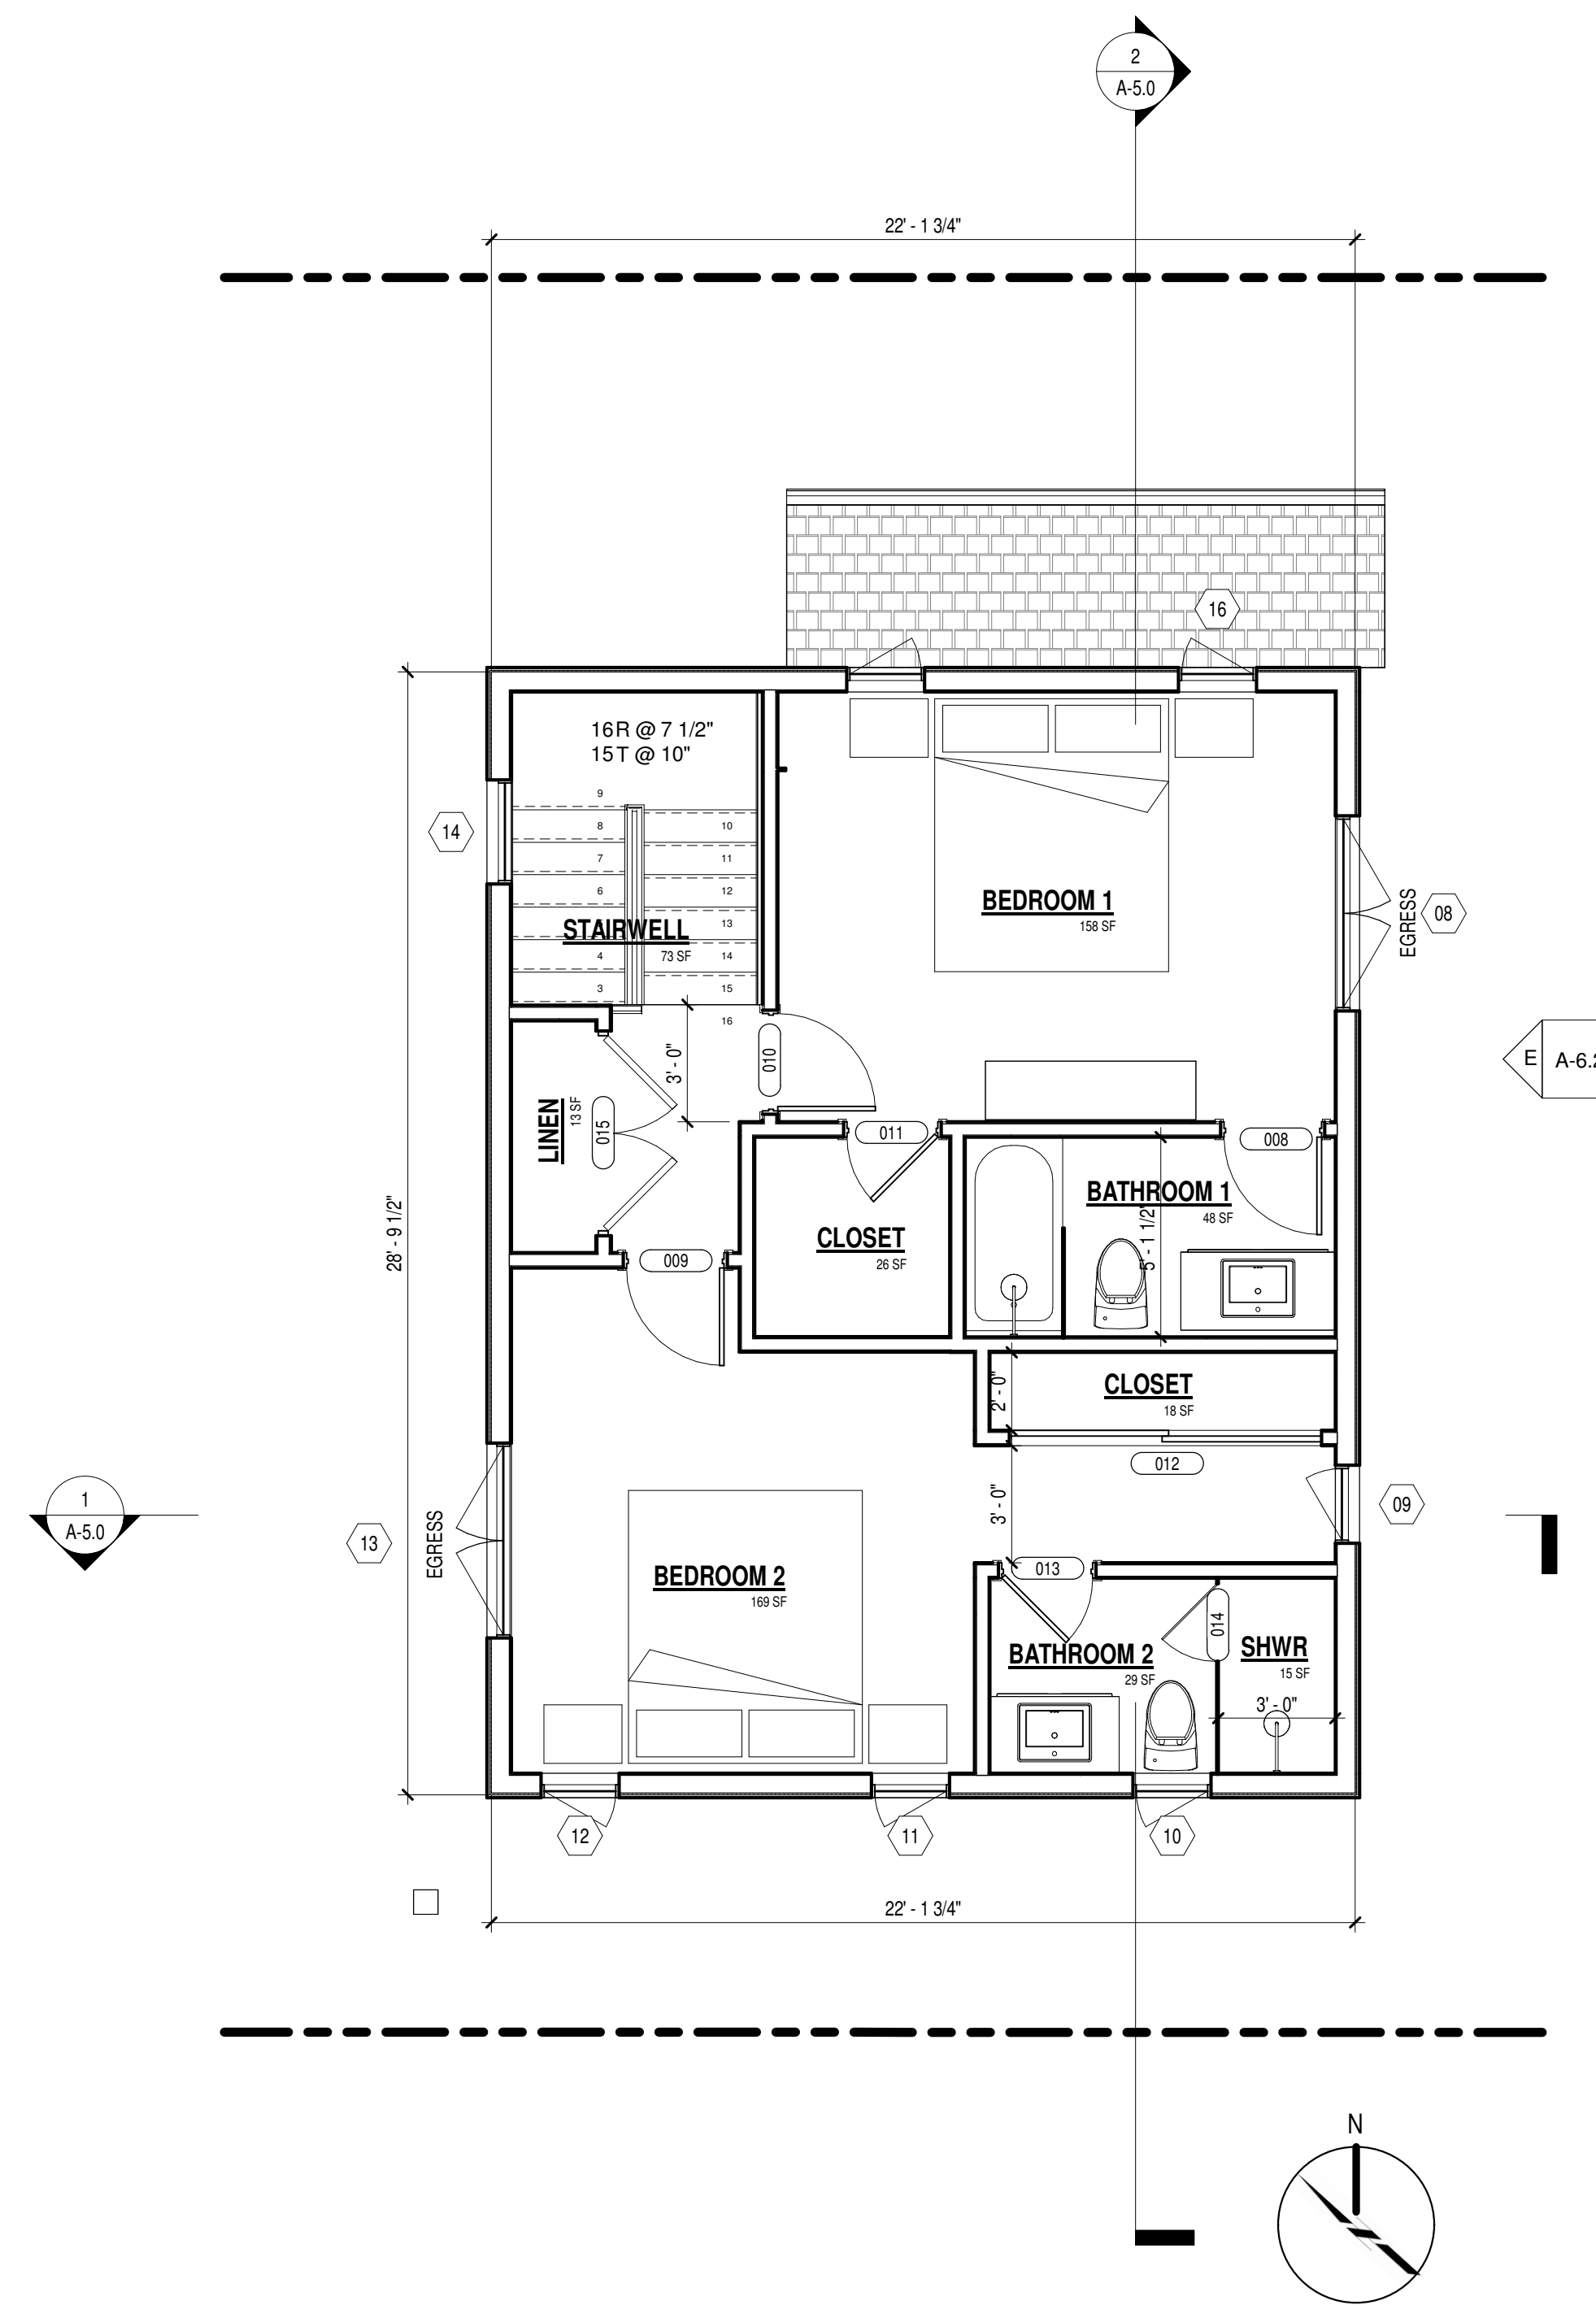

2ND UNIT - LEVEL 2 FLOOR PLAN
SCALE: 1/4" = 1'-0"

2

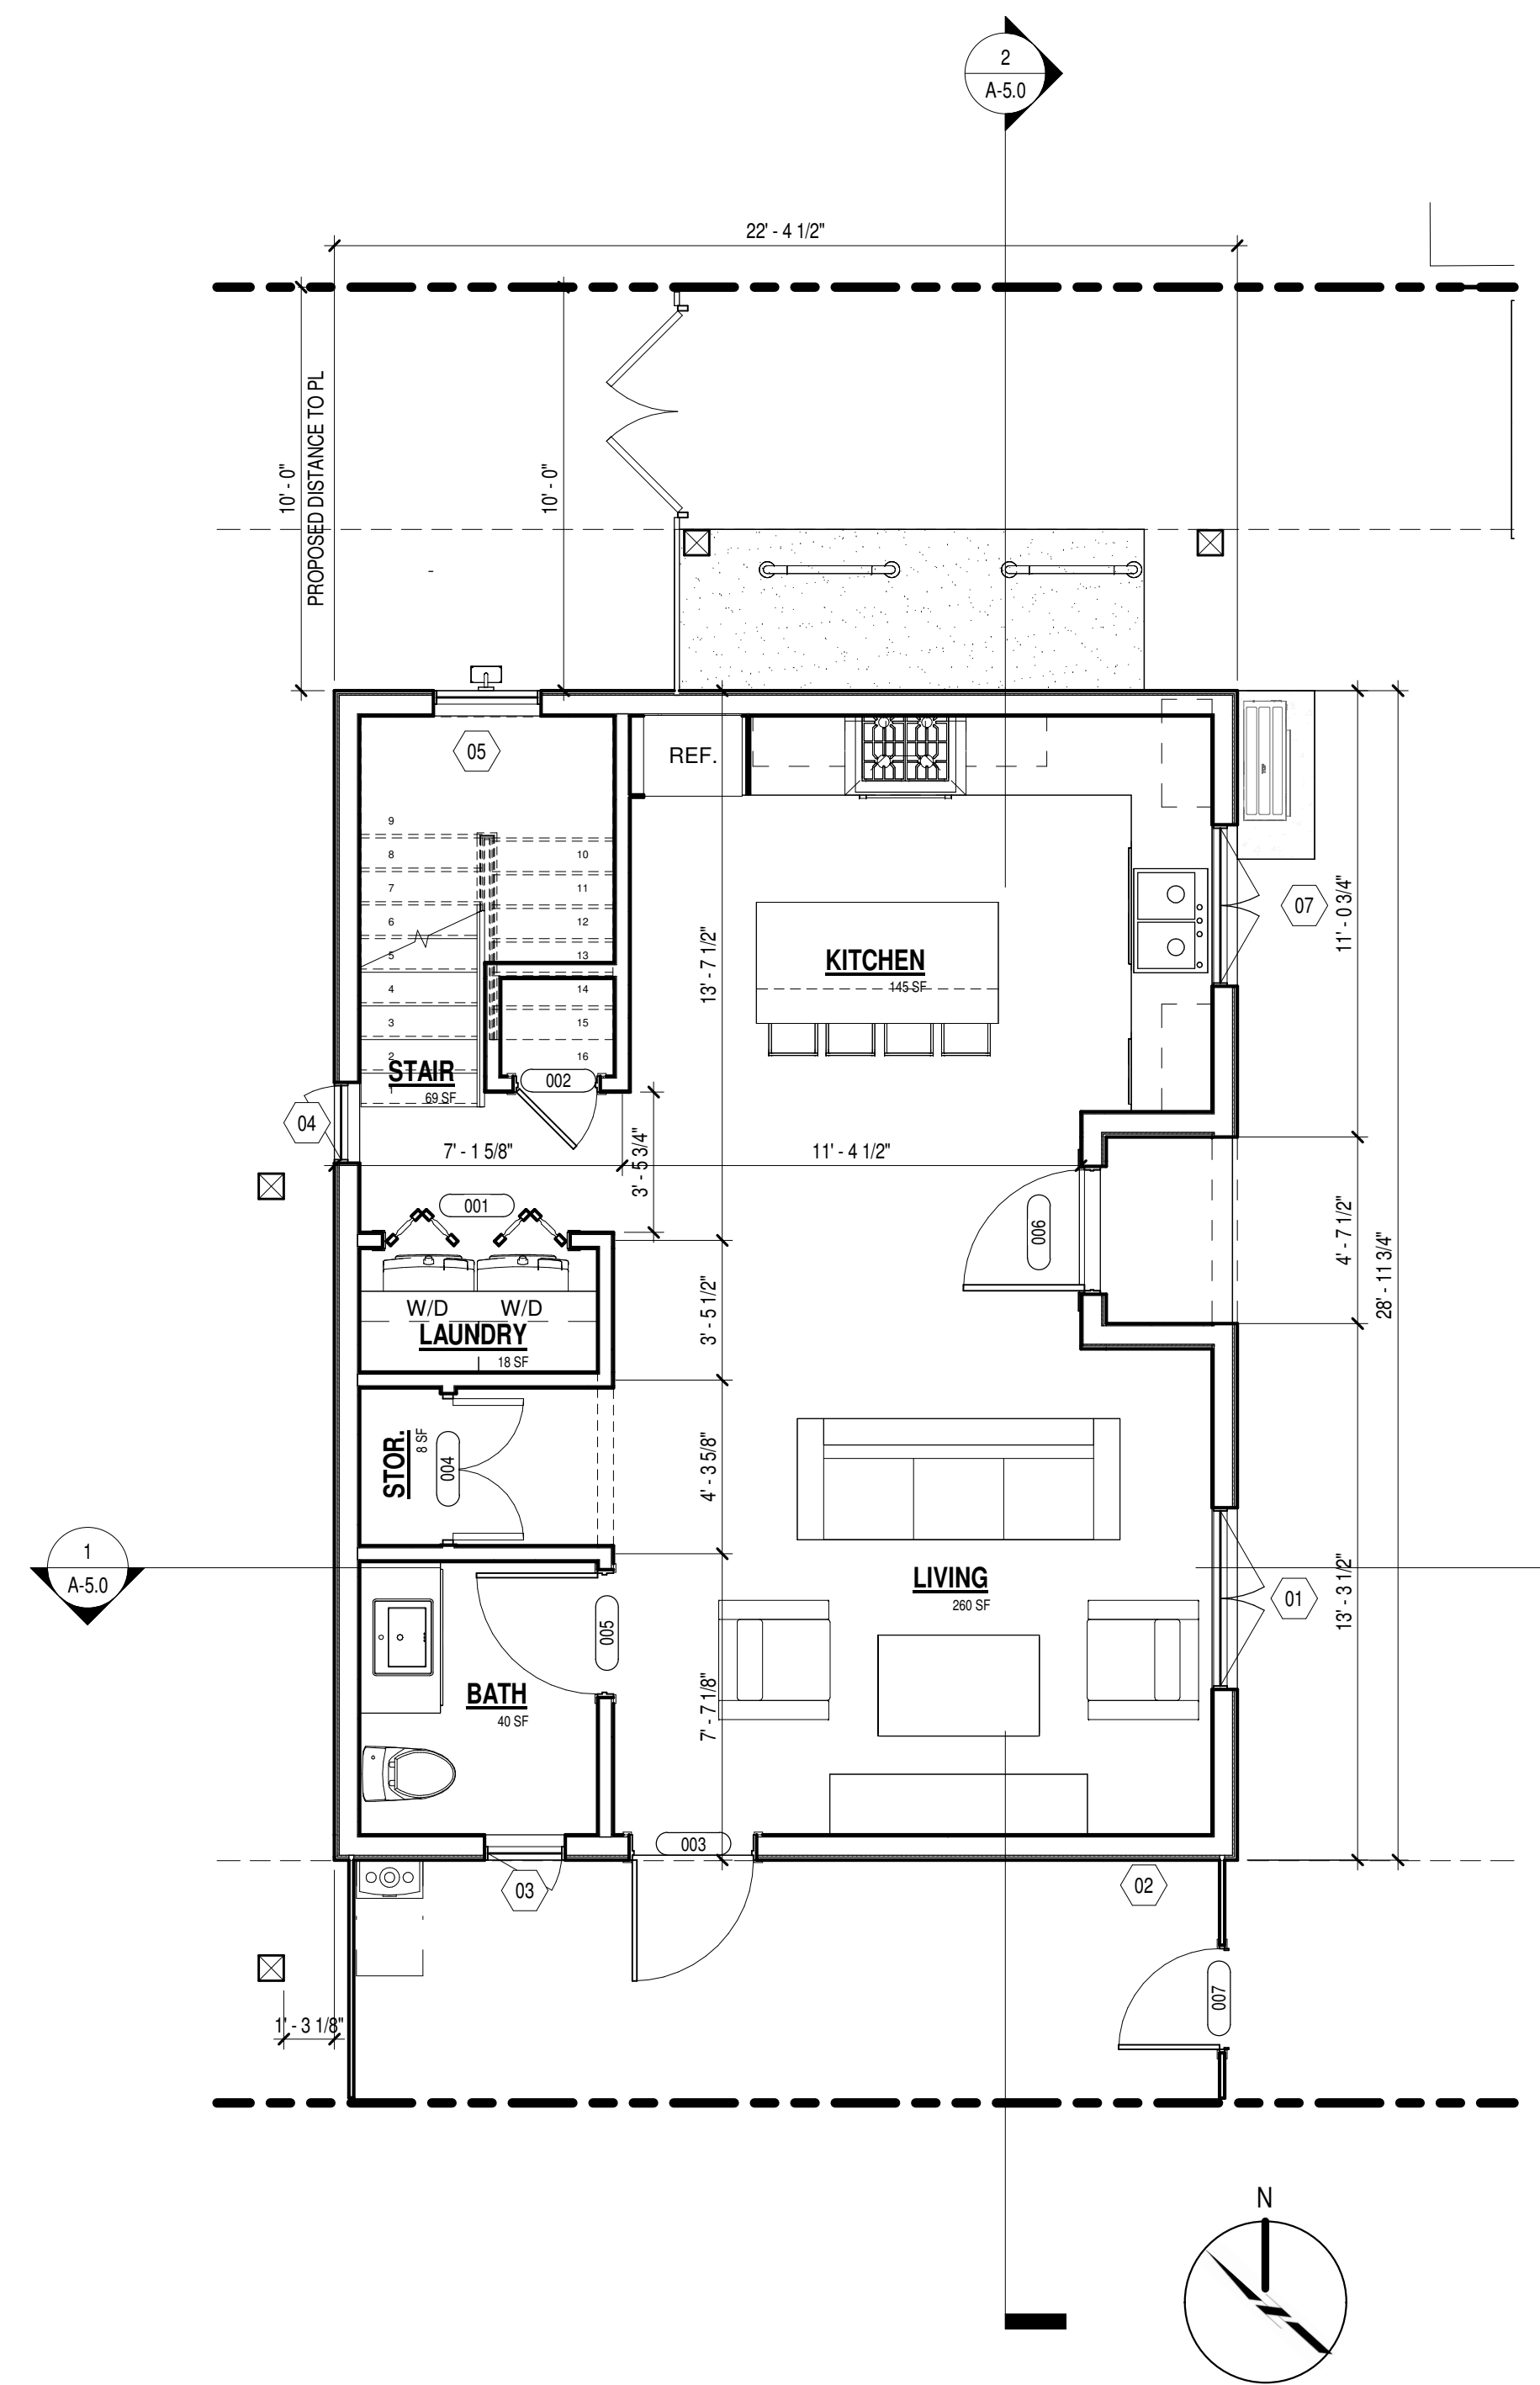

2ND UNIT - LEVEL 1 FLOOR PLAN
SCALE: 1/4" = 1'-0"

1



THOMAS OCHSNER
Architect

ARCHITECTURE & PLANNING

Thomas
Ochsner AIA
Architect

1847 State Street
Santa Barbara, CA 93101
Tel 805.770.7576
Cel 805.705.6558
tom@toarchitect.com
www.toarchitect.com

CLIENT

Emilio Ruggiero

PROJECT

DETACHED
ACCESSORY
DWELLING UNIT

1308 CACIQUE ST, SANTA
BARBARA, CA, 93101

SHEET TITLE

PROPOSED
SECTIONS

REVISIONS




PROJECT NAME DETACHED ACCESSORY
DWELLING UNIT

DATE DRAWN

DATE 01/23/24


SHEET NO.

A-5.0

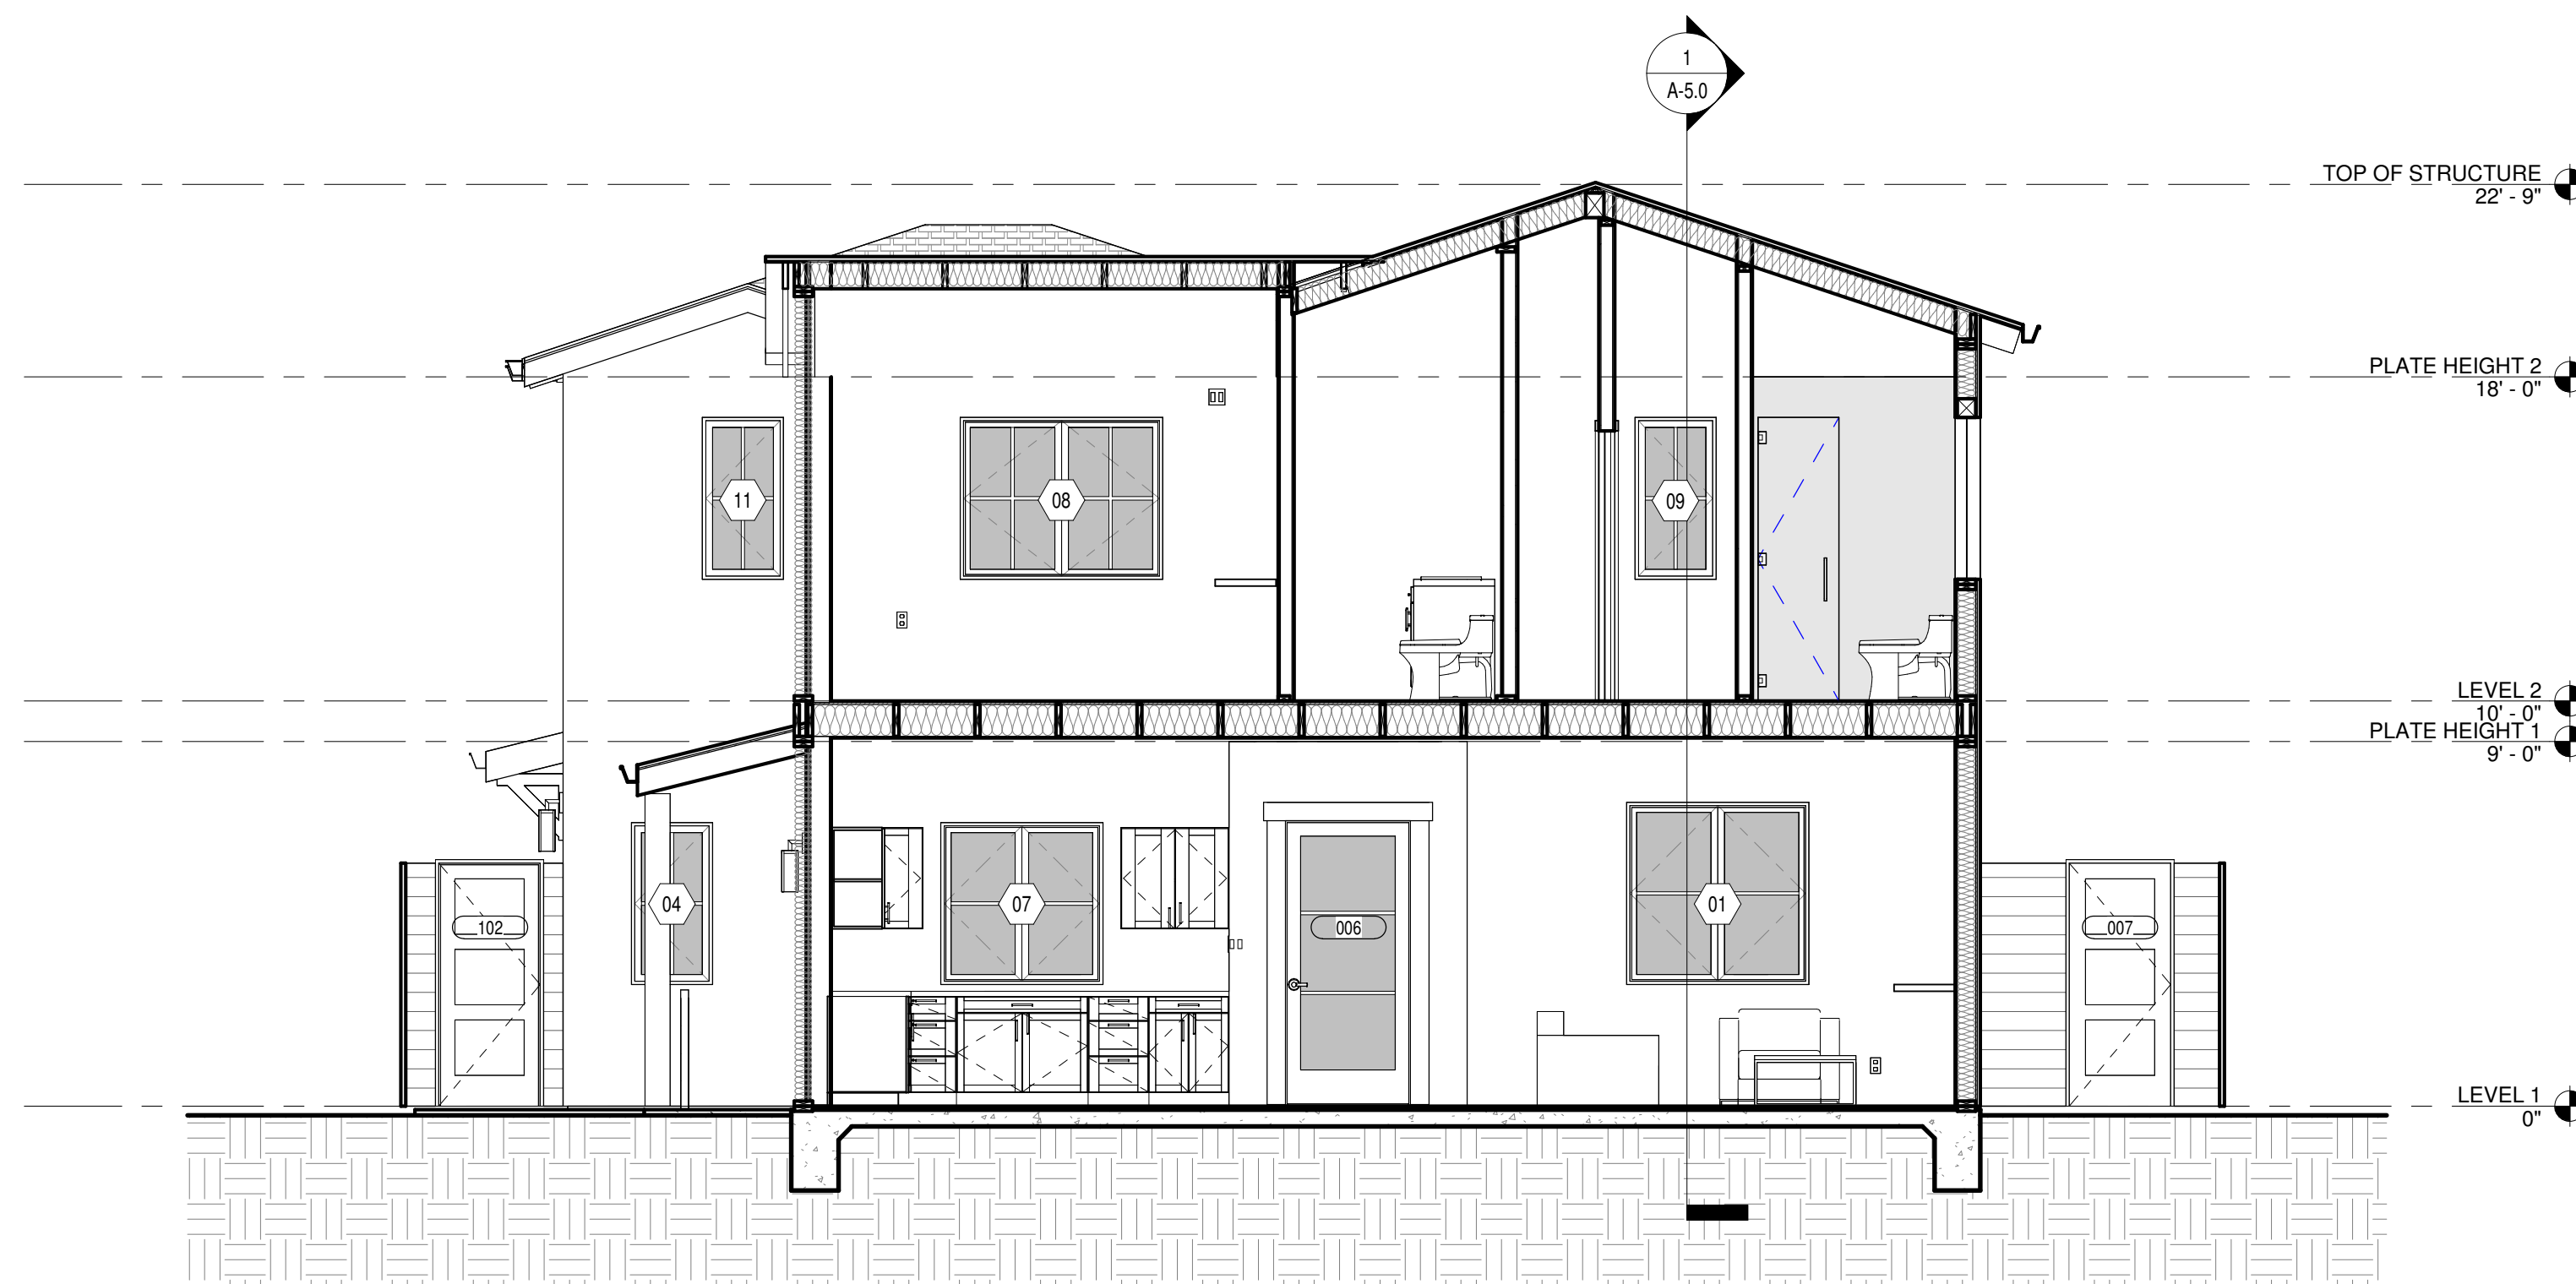

SECTION 2
SCALE: 1/4" = 1'-0"

2

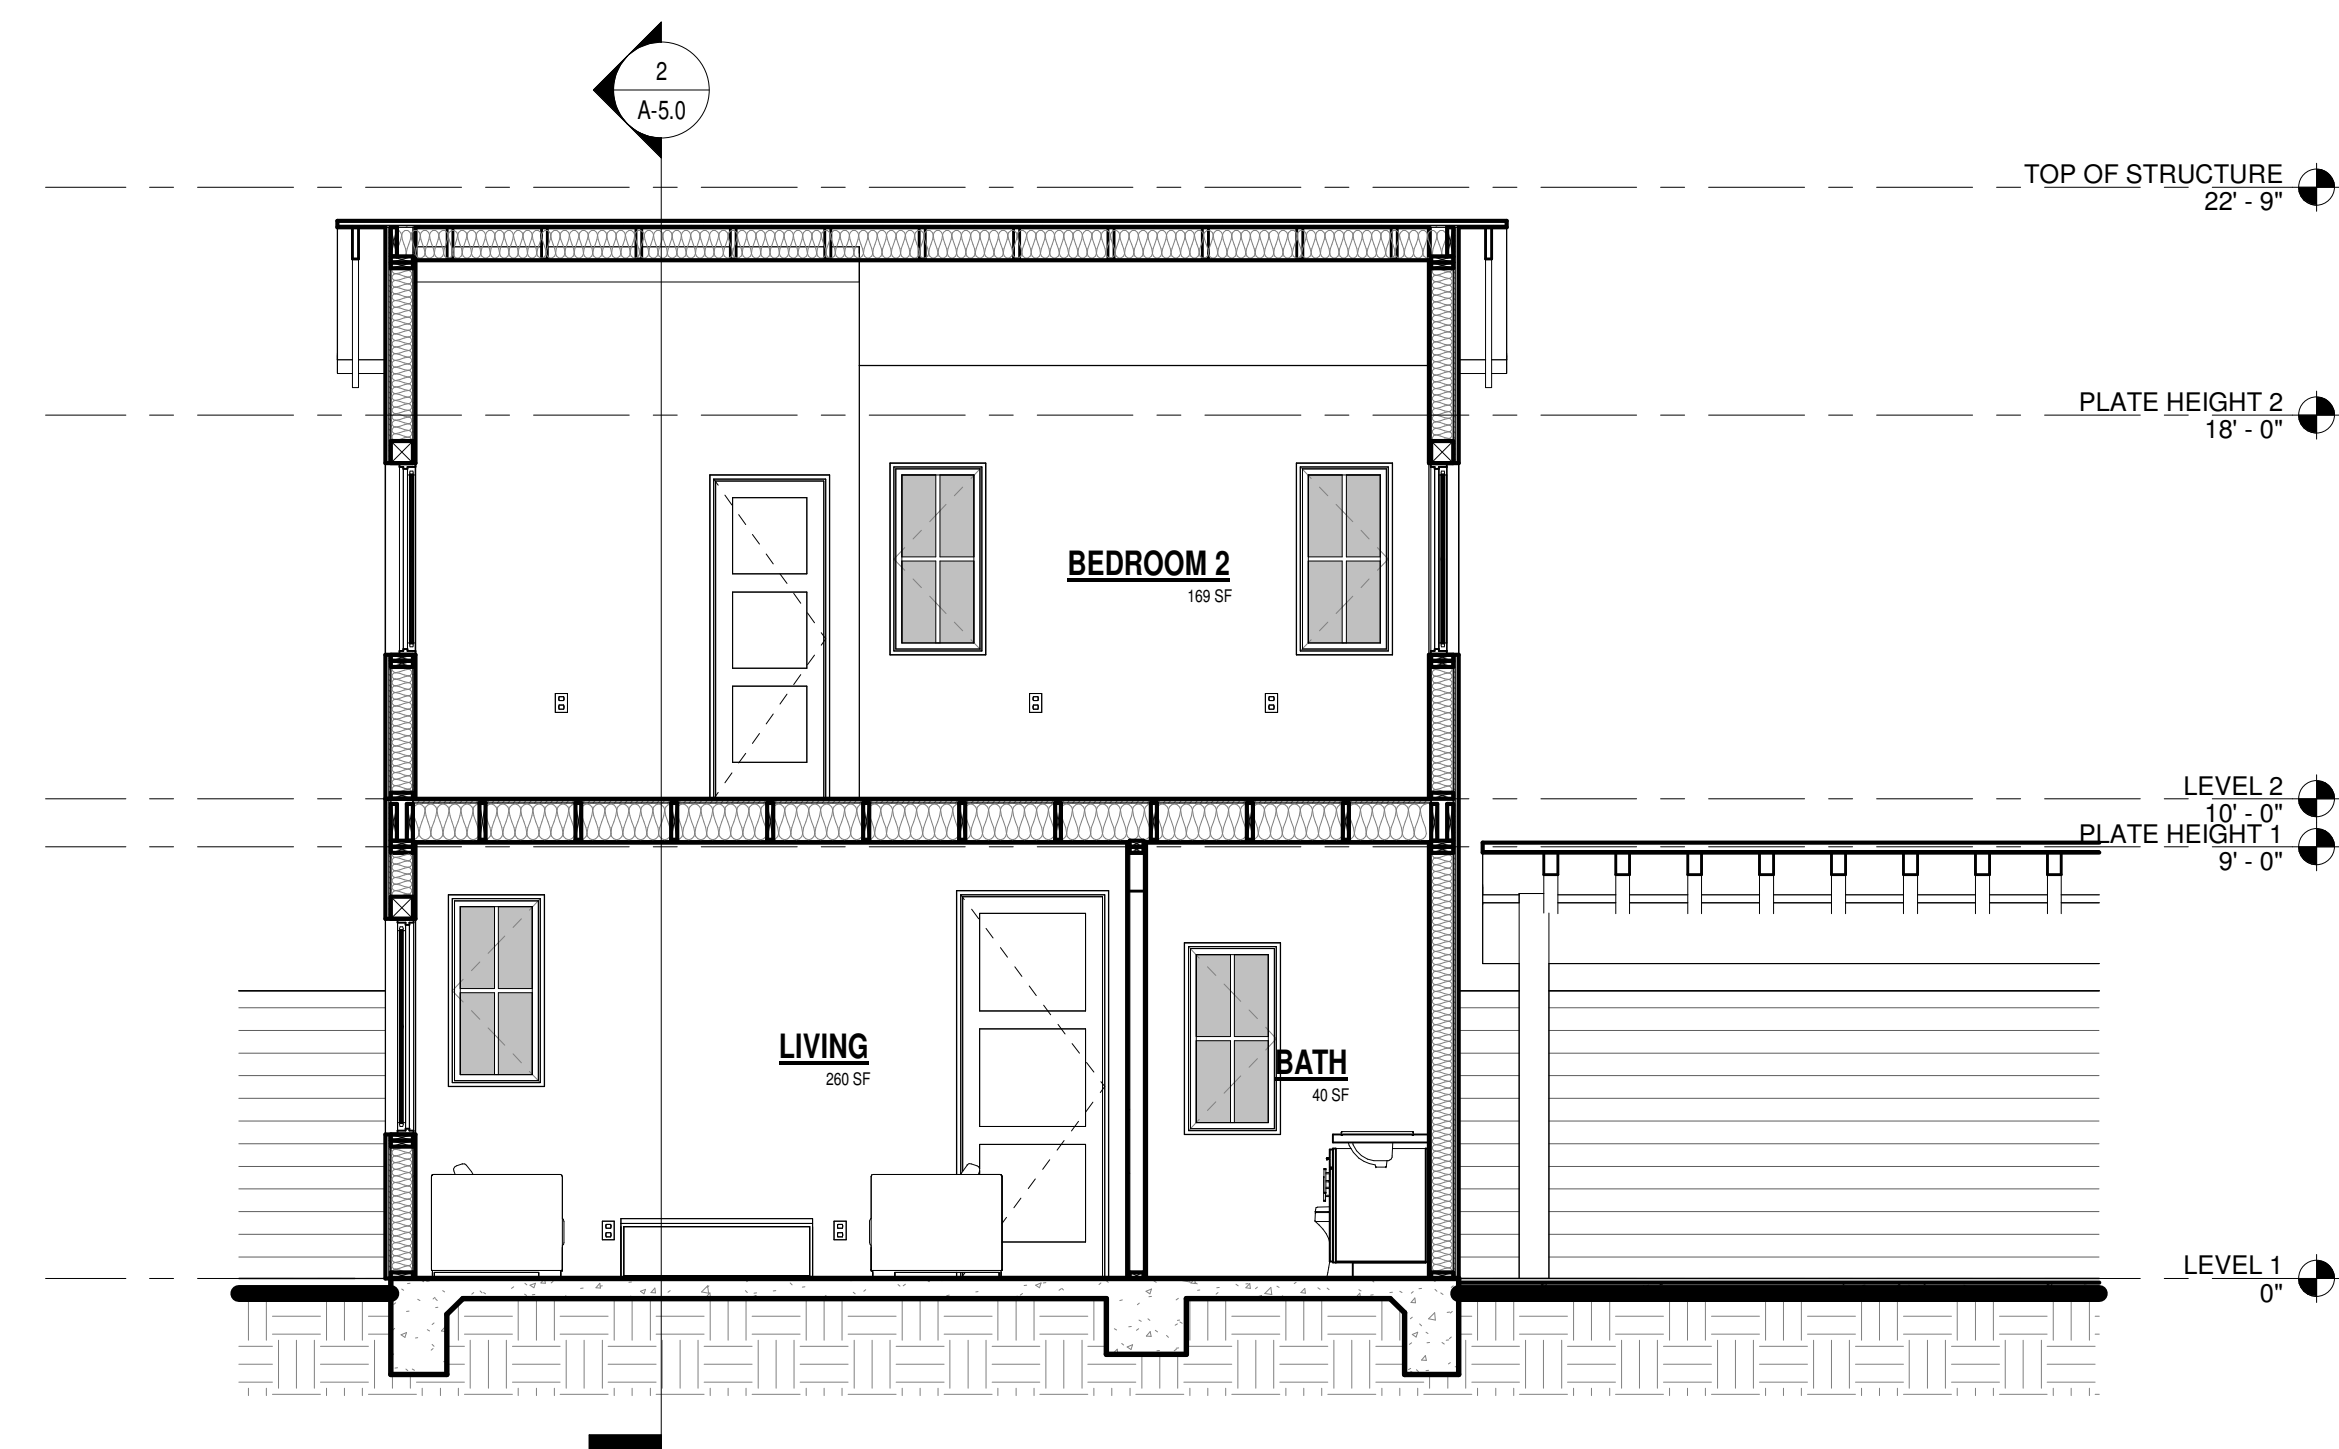

SECTION 1
SCALE: 1/4" = 1'-0"

1



THOMAS OCHSNER
Architect

ARCHITECTURE & PLANNING

Thomas
Ochsner AIA
Architect

1847 State Street
Santa Barbara, CA 93101
Tel 805.770.7576
Cel 805.705.6558
tom@toarchitect.com
www.toarchitect.com

CLIENT

Emilio Ruggiero

PROJECT

DETACHED
ACCESSORY
DWELLING UNIT

1308 CACIQUE ST, SANTA
BARBARA, CA, 93101

SHEET TITLE

PROPOSED
EXTERIOR
ELEVATIONS

REVISIONS

Date: Revision:



PROJECT NAME DETACHED ACCESSORY
DWELLING UNIT


DATE DRAWN

DATE 12/21/2020


SHEET NO.

EXTERIOR FINISH & MATERIAL INDEX


TAG	DESCRIPTION
EX-01	SHINGLE ROOFING, COLOR TO MATCH MAIN RESIDENCE MANUFACTURER: CERTAINTED
EX-02	EXTERIOR PLASTER, SMOOTH FINISH COLOR: LIGHT GRAY
EX-03	EXPOSED HEAVY TIMBER WOOD FRAMING PAINTED WHITE
EX-04	ALUM. CLAD DOORS & WINDOWS COLOR: WHITE. TRIM: WHITE

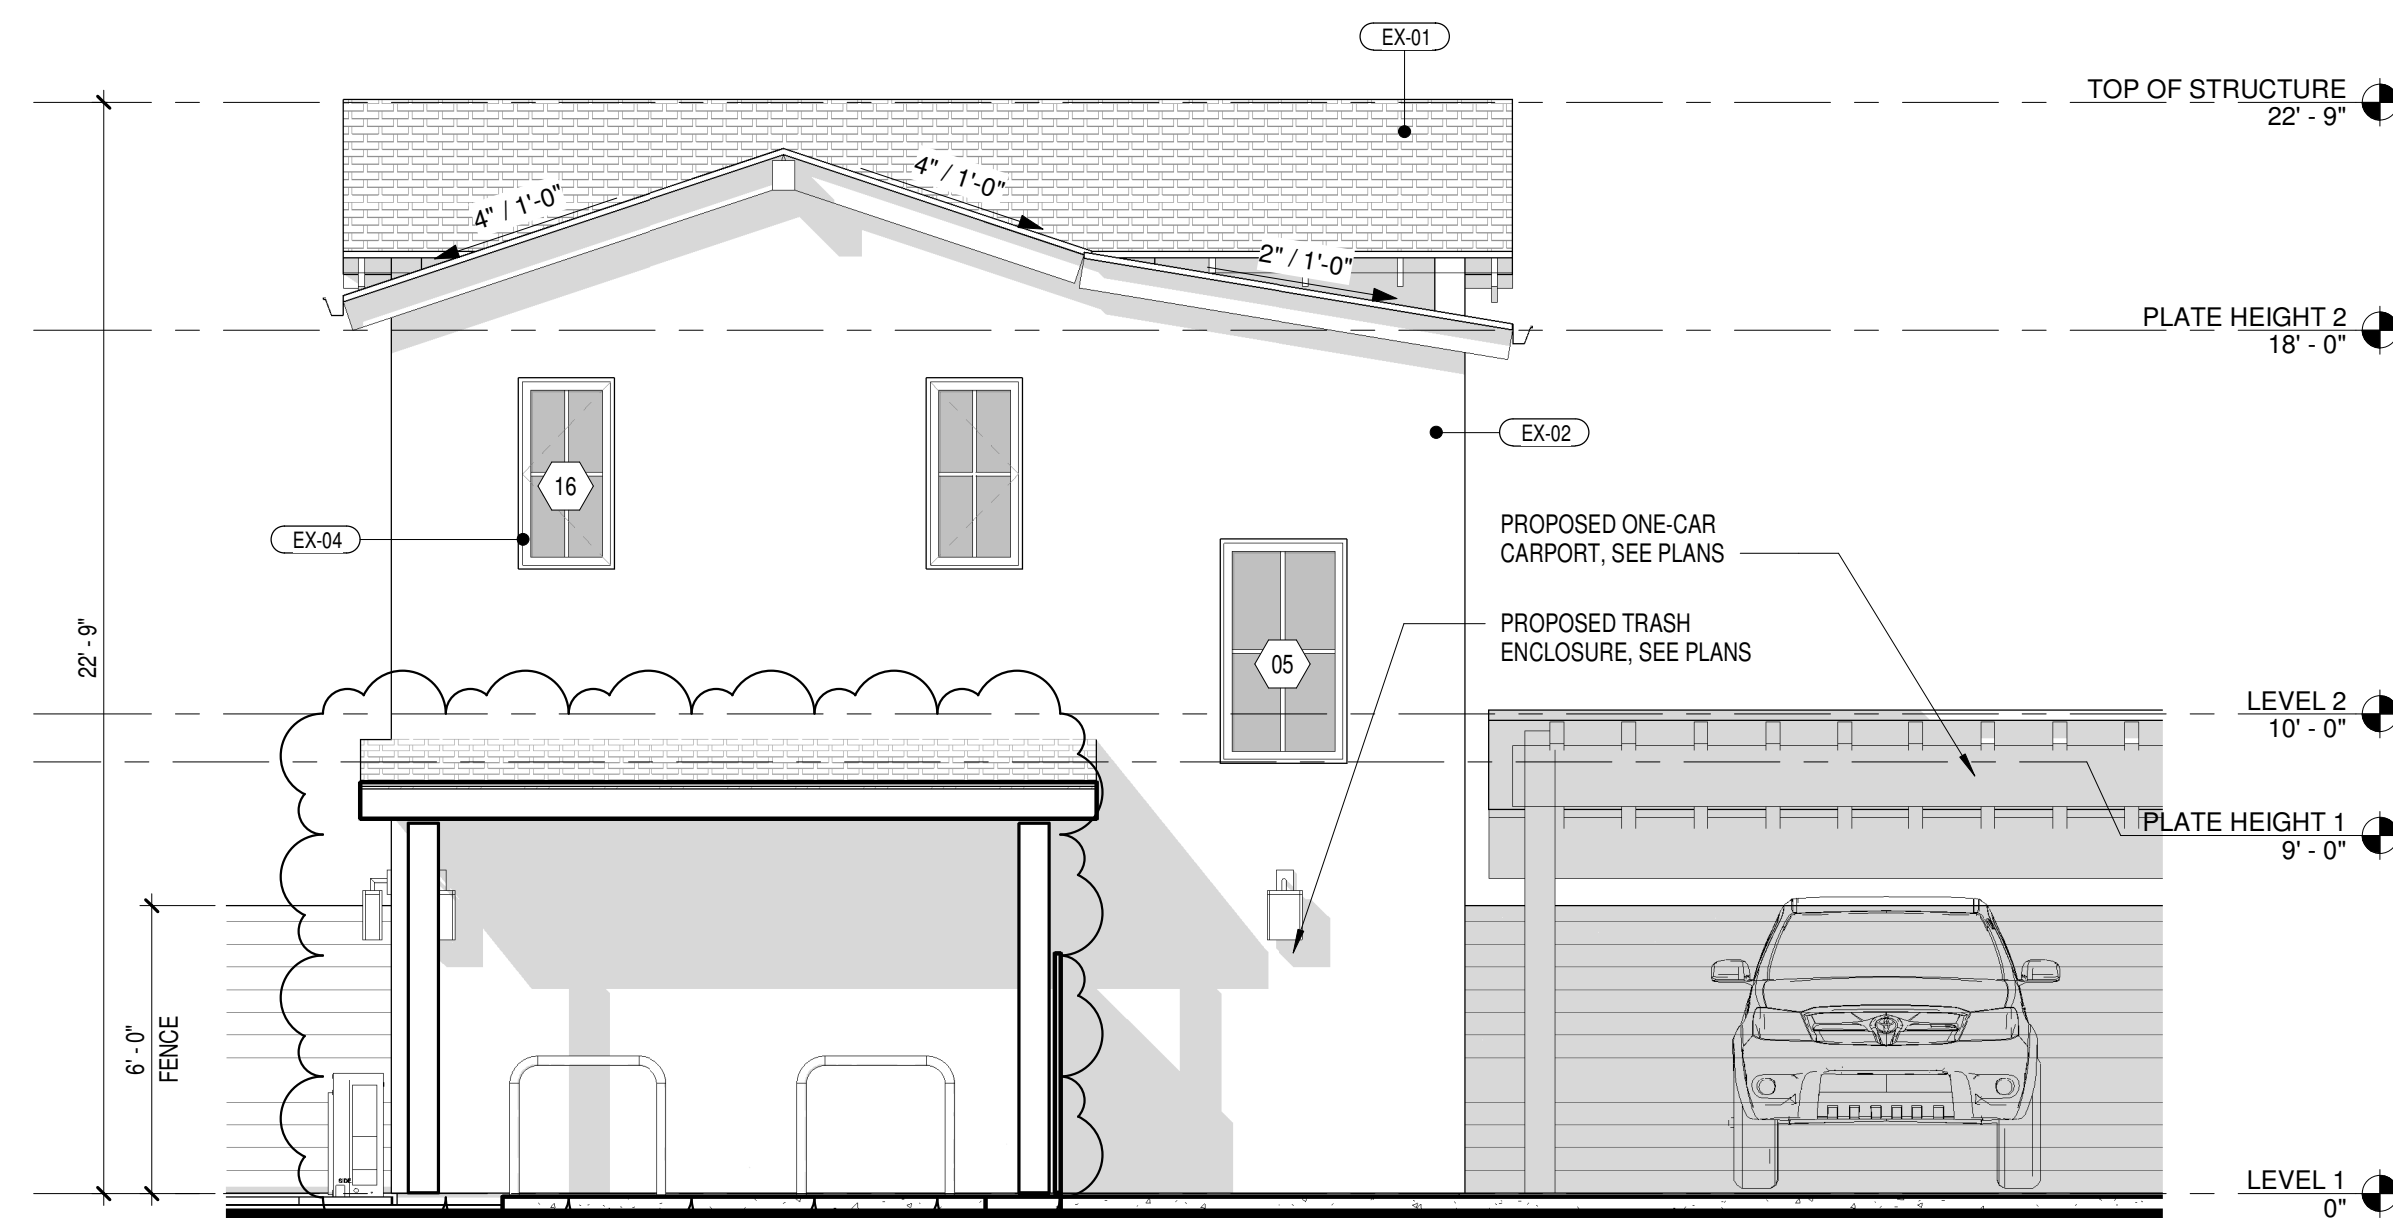


NORTH ELEVATION **N**
SCALE: 1/4" = 1'-0"

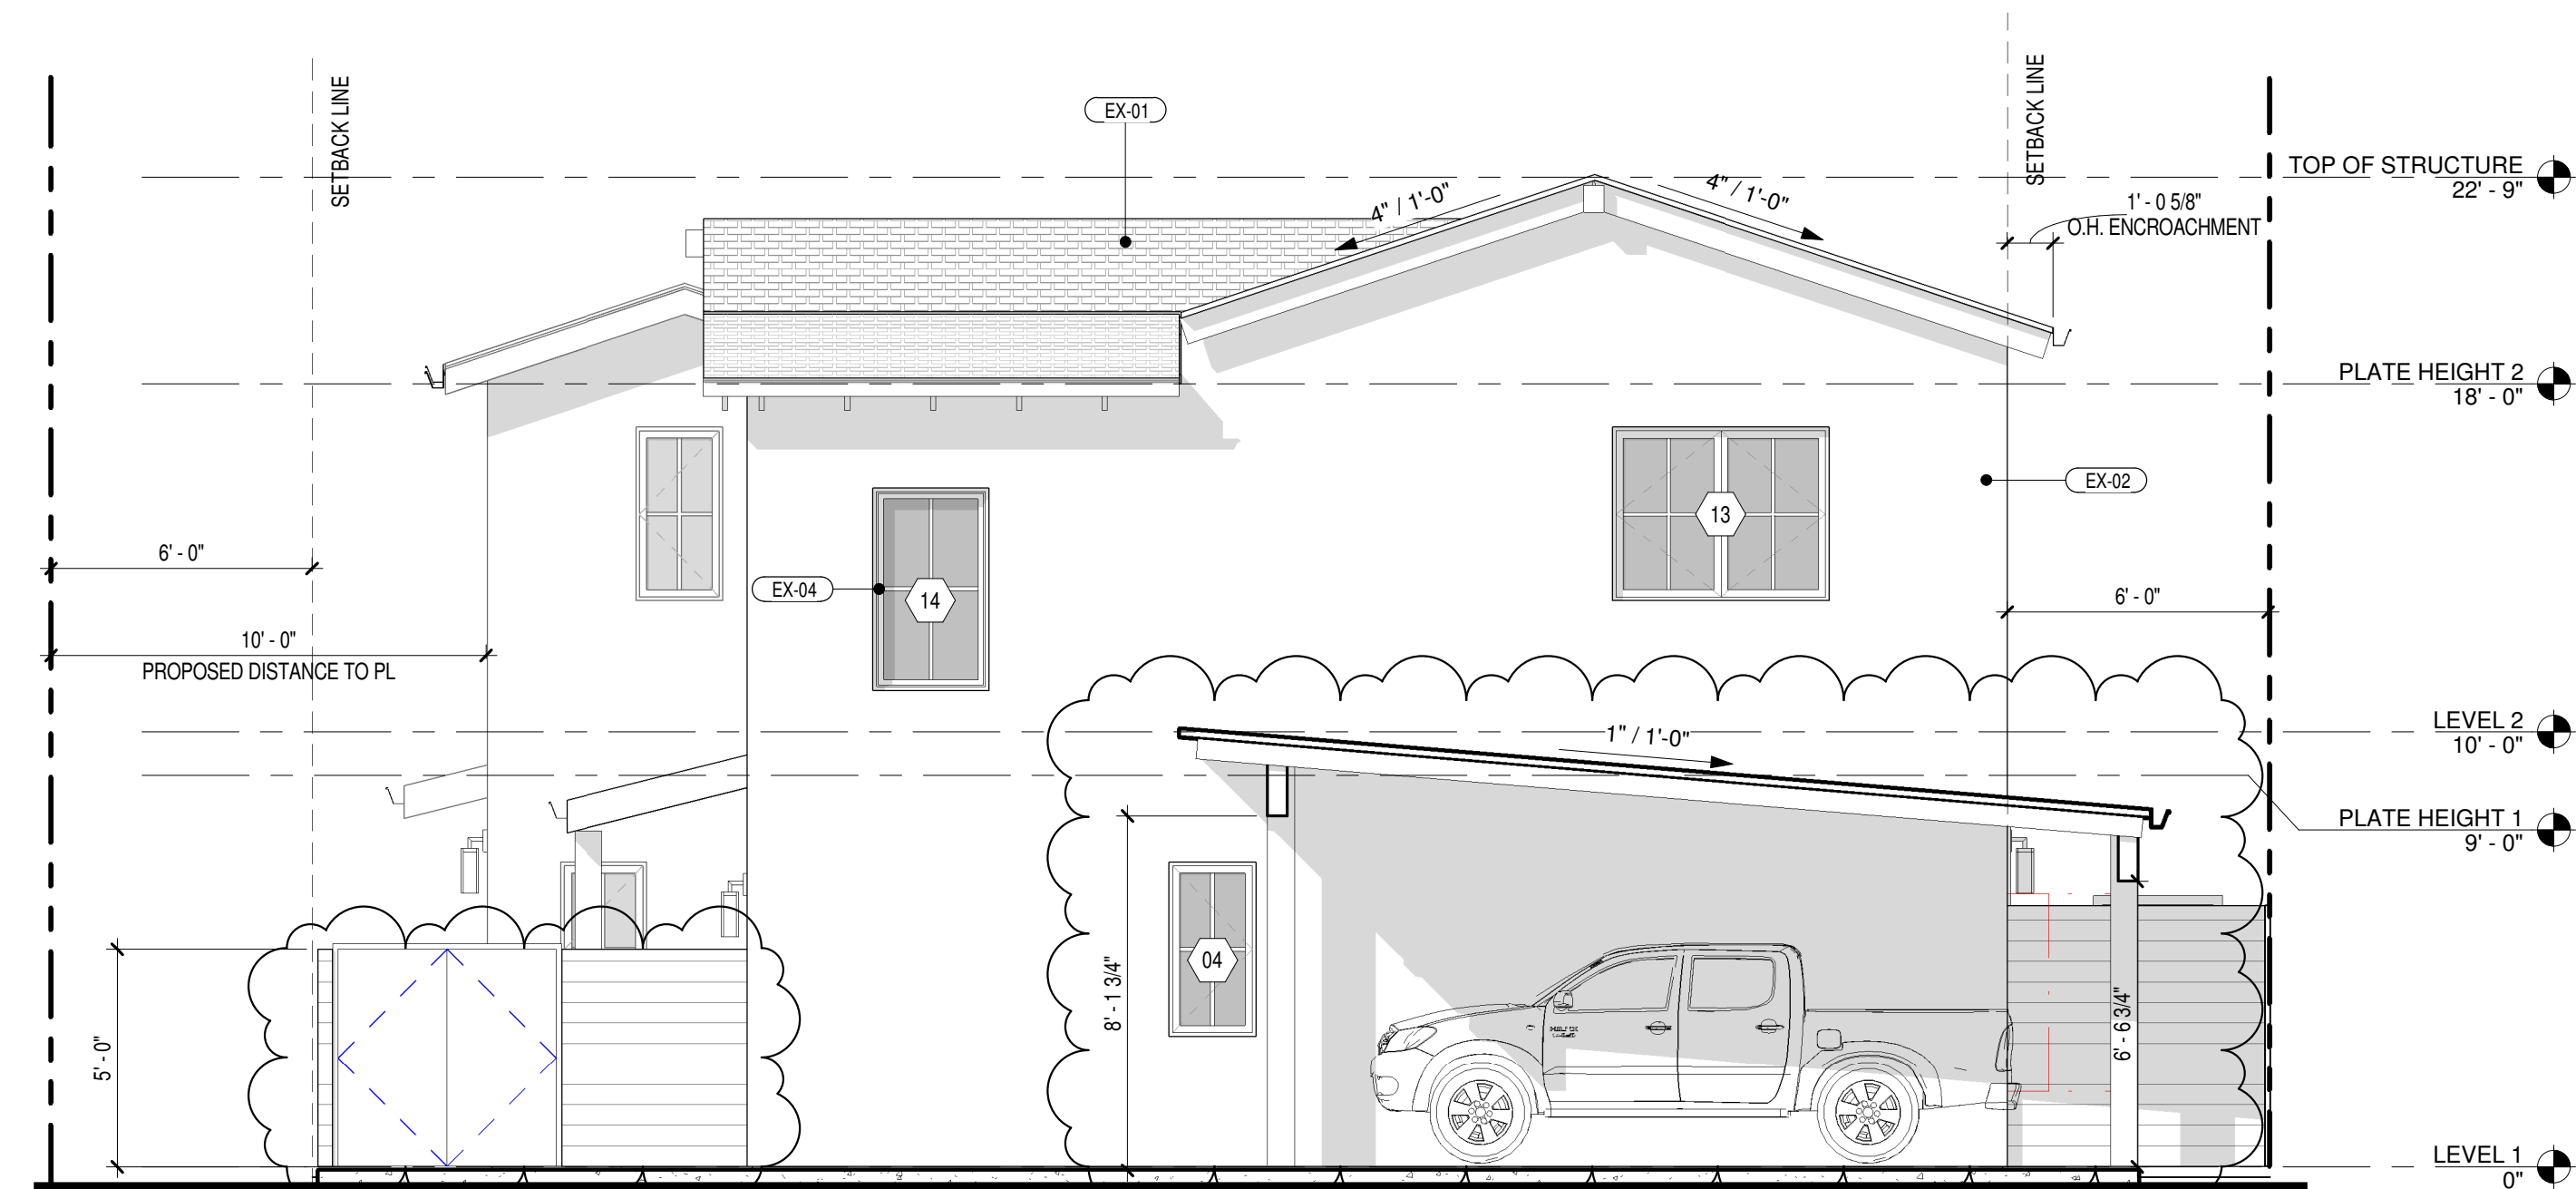

WEST ELEVATION **W**
SCALE: 1/4" = 1'-0"

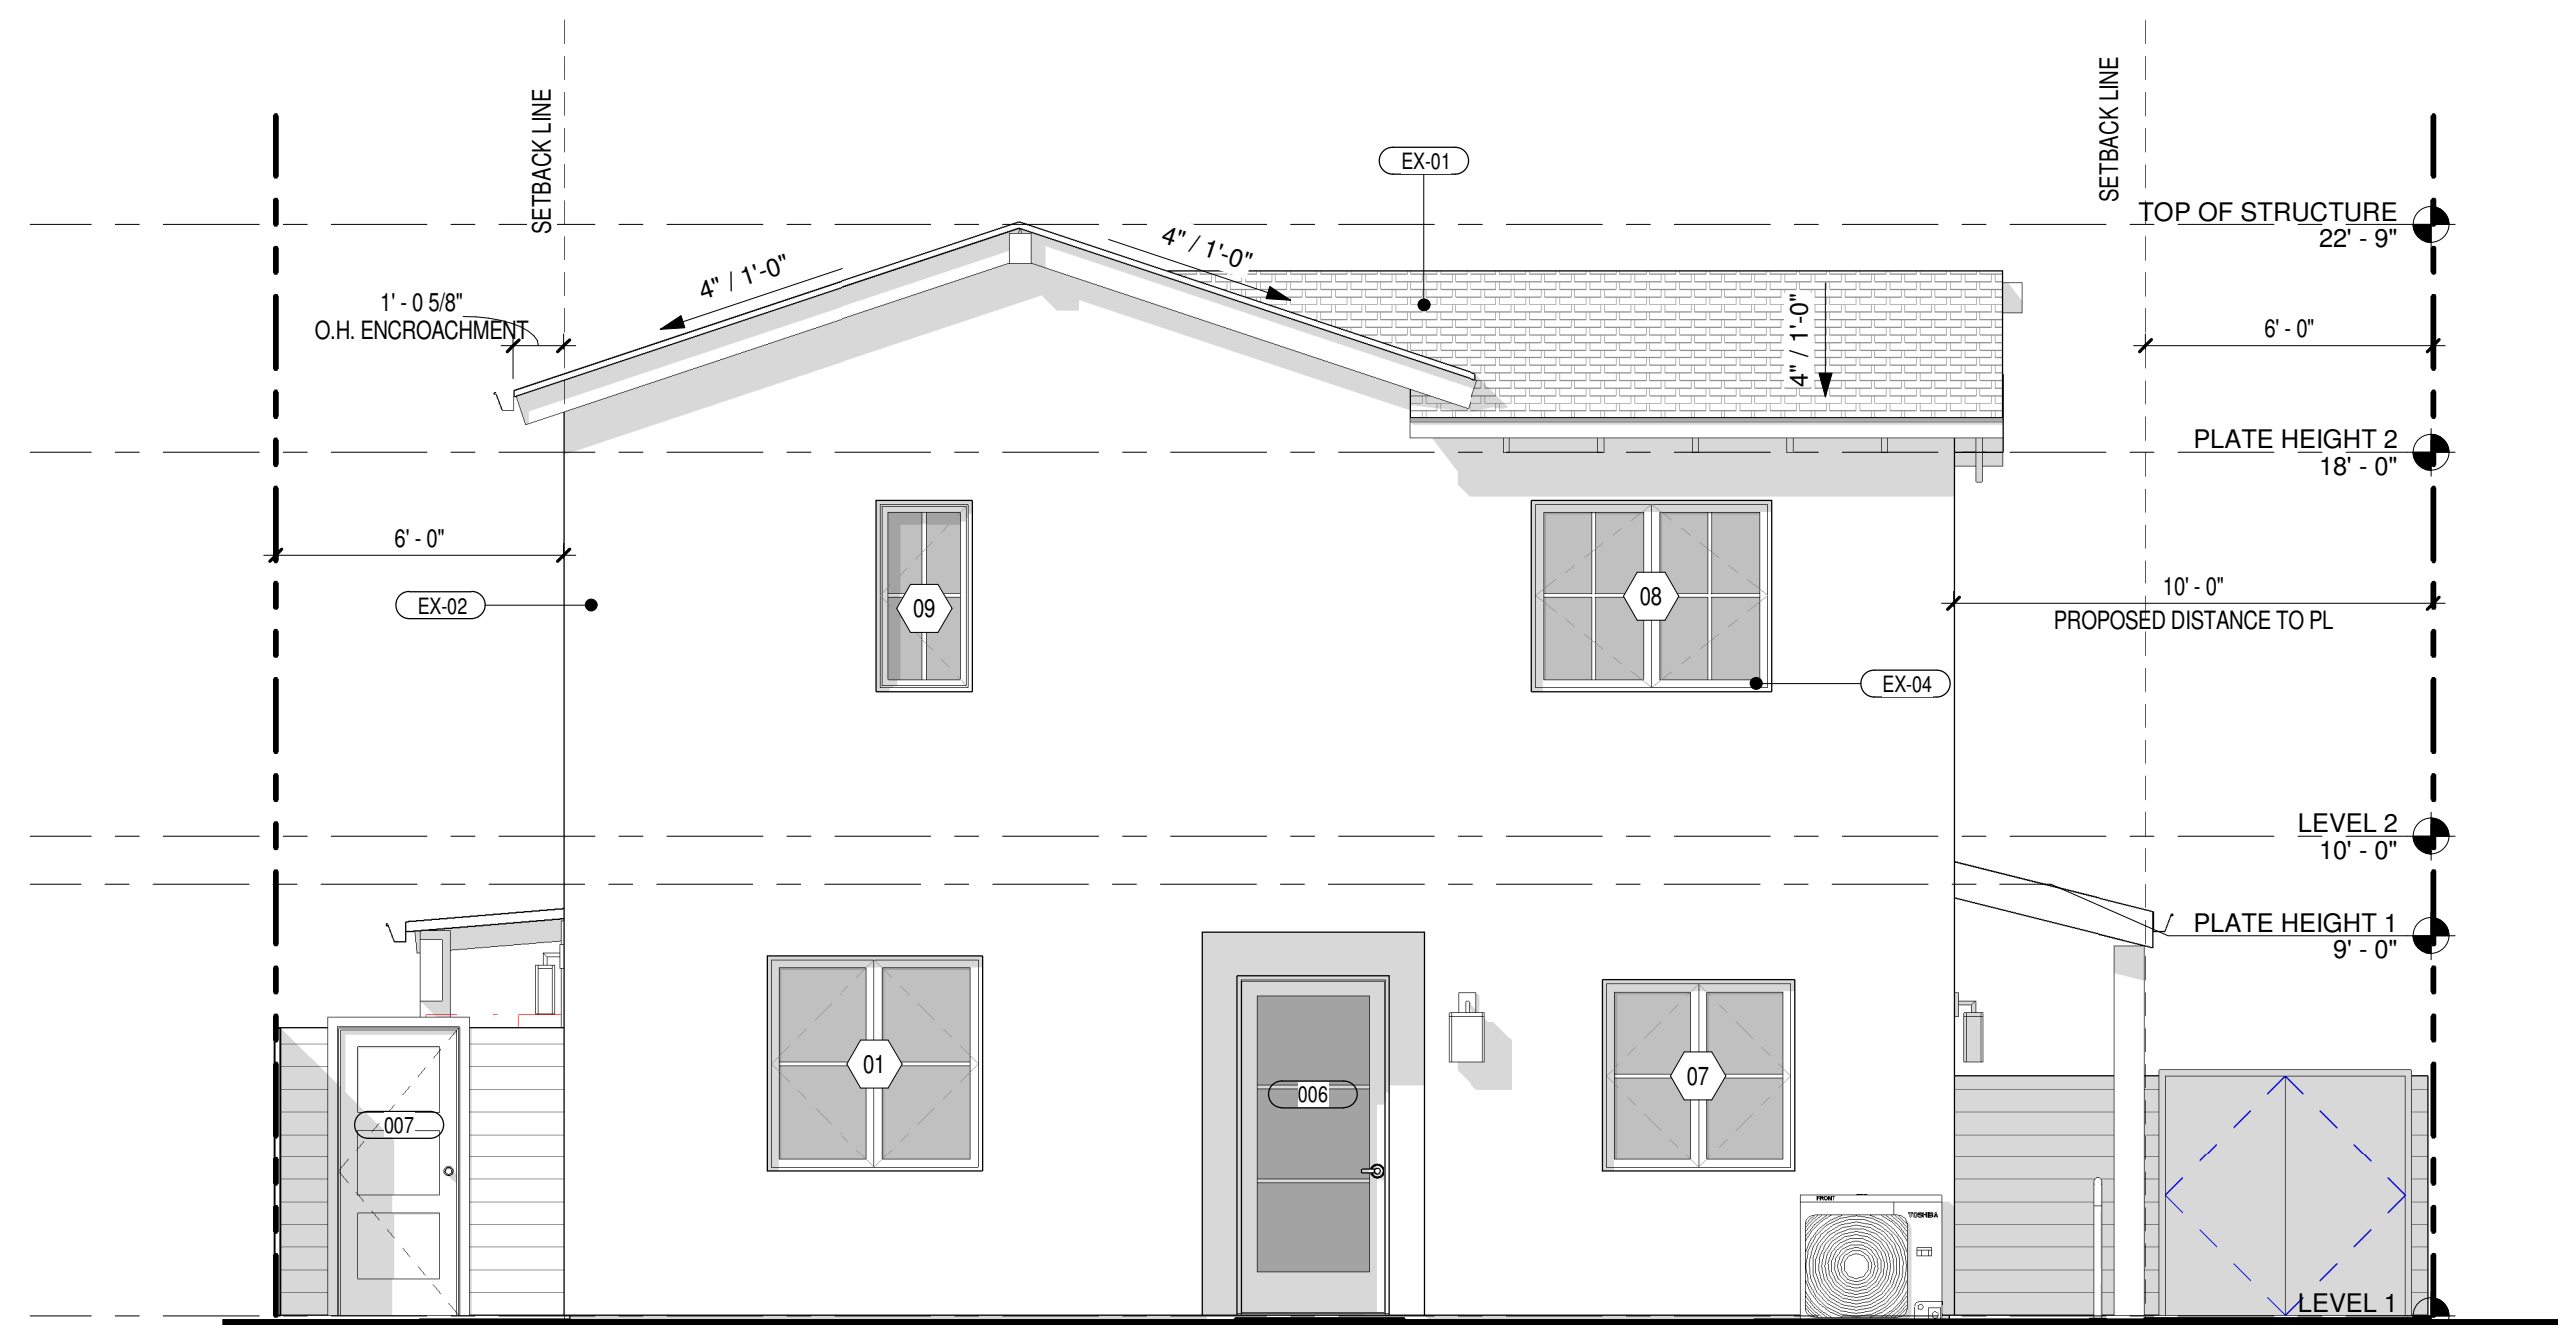

EAST ELEVATION **E**
SCALE: 1/4" = 1'-0"

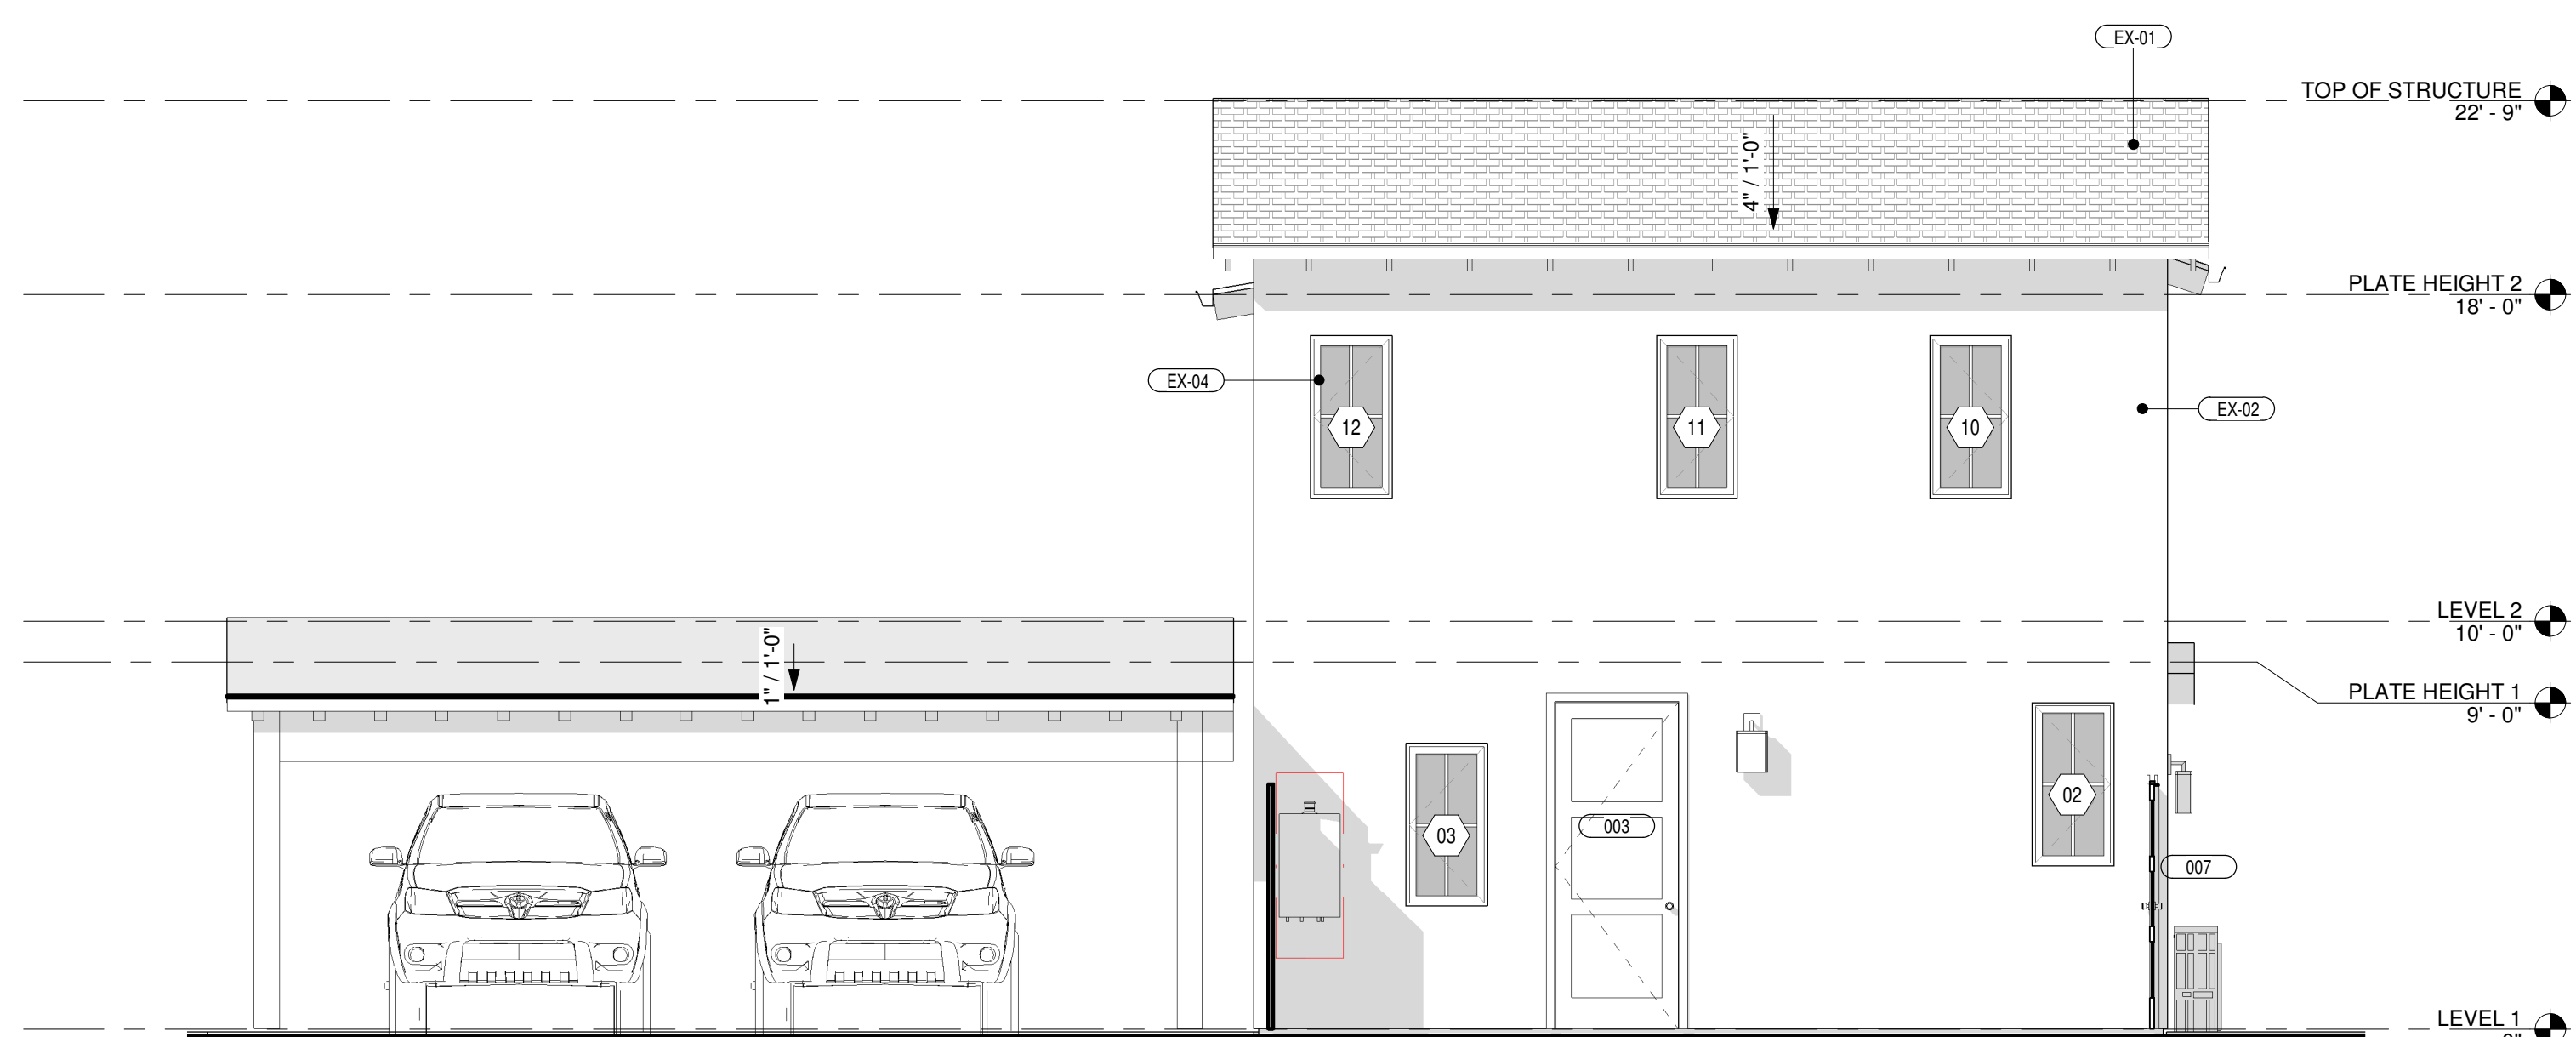

SOUTH ELEVATION **S**
SCALE: 1/4" = 1'-0"



THOMAS OCHSNER
Architect

ARCHITECTURE & PLANNING

Thomas
Ochsner AIA
Architect

1847 State Street
Santa Barbara, CA 93101
Tel 805.770.7576
Cel 805.705.6558
tom@toarchitect.com
www.toarchitect.com

CLIENT

Emilio Ruggiero

PROJECT

DETACHED
ACCESSORY
DWELLING UNIT

1308 CACIQUE ST, SANTA
BARBARA, CA, 93101

SHEET TITLE

DOOR AND WINDOW
SCHEDULE

REVISIONS



PROJECT NAME DETACHED ACCESSORY
DWELLING UNIT

DATE DRAWN

DATE 12/21/2020

SHEET NO.

A-8.2

GENERAL NOTES - WINDOWS


- SIZES ARE NOMINAL. ALL OPENINGS SHALL BE FIELD MEASURE AND VERIFIED WITH SHOP DRAWINGS PRIOR TO FABRICATION.
- ALL GLAZING IN DOORS AND ENCLOSURES FOR HOT TUBS, WHIRLPOOLS, SAUNAS, BATHTUBS AND SHOWERS WHERE THE BOTTOM EXPOSED EDGE OF THE GLAZING IS LESS THAN 60" ABOVE A STANDING SURFACE SHALL BE TEMPERED PER CBC 2406.3.5. ALL GLAZING, OPERABLE OR INOPERABLE, ADJACENT TO A DOOR IN ALL BUILDINGS AND WITHIN THE SAME WALL PLANE AS THE DOOR WHOSE NEAREST VERTICAL EDGE IS WITHIN 24" ARC OF THE DOOR IN A CLOSED POSITION AND WHOSE BOTTOM EDGE IS LESS THAN 60" ABOVE THE FLOOR OR WALKING SURFACE SHALL BE TEMPERED PER CBC SEC. 2406.3.6. GLAZING IN FIXED PANELS OTHER THAN THOSE COVERED BY ITEMS 5 & 6 WHICH HAVE A GLAZED AREA IN EXCESS OF 9 SQUARE FEET AND THE LOWEST EDGE IS LESS THAN 18" ABOVE THE FINISHED FLOOR LEVEL OR WALKING SURFACE WITHIN 36" OF SUCH GLAZING SHALL BE TEMPERED PER CBC SEC. 2406.3.7. GLAZING ADJACENT TO STAIRWAYS, LANDINGS AND RAMPS WITHIN 36" HORIZONTALLY OF A WALKING SURFACE; WHEN THE EXPOSED SURFACE OF THE GLASS IS LESS THAN 60" ABOVE THE PLANE OF THE ADJACENT WALKING SURFACE SHALL BE TEMPERED PER CBC 2406.3.10. GLAZING ADJACENT TO STAIRWAYS WITHIN 60" HORIZONTALLY OF THE BOTTOM TREAD OF THE STAIRWAY IN ANY DIRECTION WHEN THE EXPOSED SURFACE OF THE GLASS IS LESS THAN 60" ABOVE THE NOSE OF THE TREAD SHALL BE TEMPERED PER CBC SECTION 2406.3.11.
- SEE DETAILS FOR INSTALLATION DETAILS.
- CONTRACTOR TO VERIFY WALL THICKNESS & COORDINATE JAMB WIDTH ACCORDINGLY.
- PER CBC CODES 2013, SECTION 2406, ALL GLAZING INSTALLED IN HAZARDOUS LOCATIONS SHALL BE SAFETY GLASS. THE SPECIFIC HAZARDOUS LOCATIONS FOR THE PURPOSES OF GLAZING SHALL BE PER CBC 2013, 2406.3, 1-11.
- FIELD VERIFY ALL WINDOW DIMENSION ROUGH OPENINGS. VERIFY DIMENSIONS WITH HEAD, JAMB, SILL & DETAILS.
- ALL GLAZING SHALL BE SPECIFIED TO MATCH REQUIREMENTS OF ATTACHED TITLE 24 CALCULATIONS SHEET
- PROVIDE EMERGENCY EXIT DOOR OR WINDOW FROM SLEEPING ROOM(S) BELOW THE FOURTH STORY ABOVE GROUND PLANE. NET CLEAR WINDOW OPENING AREA SHALL BE NOT LESS THAN 5.7 sq. ft. MIN NET WINDOW OPENING HEIGHT DIMENSION: 24" CLEAR. MIN NET WINDOW OPENING WIDTH: 20" CLEAR. FINISHED SILL HEIGHT MAX 44" ABOVE FLOOR. PER CBC 1026.

DOOR/WINDOW ABBREVIATIONS


ALUM = ALUMINUM	P = PAINT
BF = BI-FOLD	PH = PANIC HARDWARE
CL = CLOSET	PR = PAIR
GL = GLASS	PF = PRE-FINISHED
HCW = HOLLOW CORE WOOD	RM = REMOVABLE MULLION
HM = HOLLOW METAL	RO = ROUGH OPENING
CF = CLEAR FINISH	SCW = SOLID CORE WOOD
CP = COPPER	STL = STEEL
CSMT = CASEMENT	T = TEMPERED
FA = FACTORY	TR = TERRACE
FX = FIXED	VGDF = VERTICAL GRAIN DOUGLAS FIR
HG = HDG	WD = WOOD
LG = LAMINATED GLASS	SS = SMOKE SEAL
MANUF. = MANUFACTURED	ST = STAIN
CLR.ANNOD. = CLEAR ANNOXIDIZED	§ = SECURITY PROVISIONS APPLY

GENERAL NOTES - DOORS

- REFER TO PLAN DRAWINGS FOR DOOR SWING.
- ALL GLAZING IN DOORS TO BE TEMPERED.
- FIELD VERIFY ALL CONDITIONS FOR PLACEMENT, SIZE, AND DETAILS.
- PER CBC 2013, SECTION 2406, ALL GLAZING IN STALLED IN HAZARDOUS LOCATIONS TO BE SAFETY GLASS
- UNDERCUT DOOR FOR MINIMUM CLEARANCE ABOVE FLOOR FINISH.
- PROVIDE DOOR SCHEDULE SHOP DRAWINGS AND HARDWARE SPECIFICATIONS FOR ARCHITECT'S APPROVAL.
- A ONE HOUR OCCUPANCY SEPARATION OCCURS BETWEEN THE HOUSE & GARAGE, DOORS TO BE (1) HOUR RATED PER CBC - SEC. 302.2, 302.4.3.

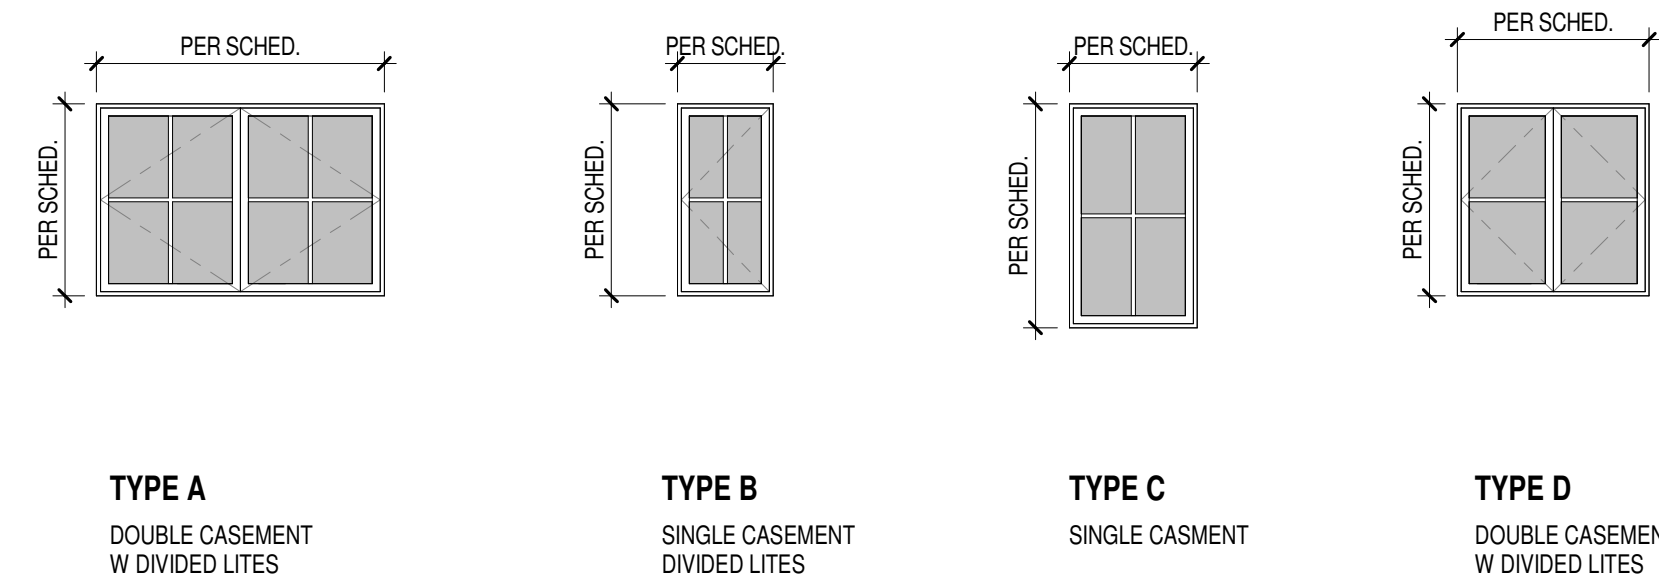

WINDOW SCHEDULE 1						
MARK	TYPE	WINDOW OPENING		COMMENTS	MARK AGAIN	Phase Created
		HEIGHT	WIDTH			
LEVEL 1						
01	A	4'-6"	4'-6"		01	Phase 2
02	B	4'-0"	2'-0"		02	Phase 2
03	B	4'-0"	2'-0"		03	Phase 2
04	B	4'-0"	2'-0"		04	Phase 2
05	C	4'-8"	2'-8"		05	Phase 2
07	D	4'-0"	4'-0"		07	Phase 2
LEVEL 2						
08	A	4'-0"	5'-0"	EGRESS	08	Phase 2
09	B	4'-0"	2'-0"		09	Phase 2
10	B	4'-0"	2'-0"		10	Phase 2
11	B	4'-0"	2'-0"		11	Phase 2
12	B	4'-0"	2'-0"		12	Phase 2
13	A	4'-0"	5'-0"	EGRESS	13	Phase 2
14	C	4'-8"	2'-8"		14	Phase 2
15	B	4'-0"	2'-0"		15	Phase 2
16	B	4'-0"	2'-0"		16	Phase 2

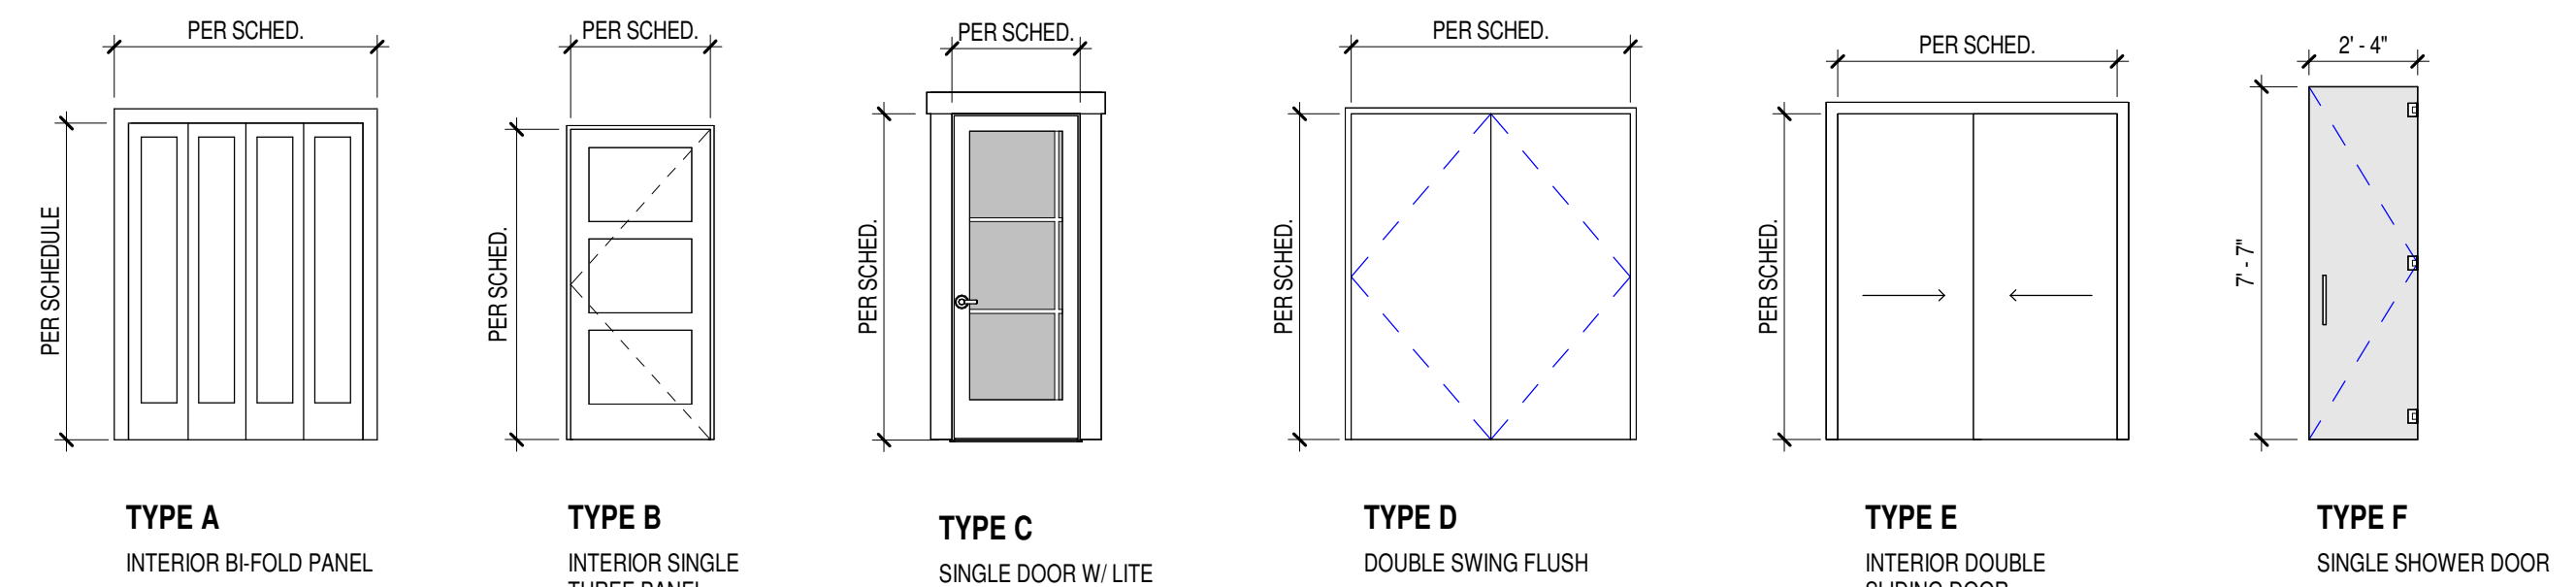

DOOR SCHEDULE						
NUMBER	Type Mark	DOOR			COMMENTS	Phase Created
		WIDT H	HEIGH T	THICKNE SS		
LEVEL 1						
001	A	4' - 6"	6' - 8"	1 25/32"		Phase 2
002	B	2' - 0"	6' - 8"	1 3/8"		Phase 2
003	B	3' - 0"	8' - 0"	1 3/8"		Phase 2
004	D	3' - 6"	7' - 0"	2"		Phase 2
005	B	3' - 0"	8' - 0"	1 3/8"		Phase 2
006	C	3' - 0"	7' - 0"	1 3/4"		Phase 2
007	B	2' - 6"	6' - 0"	1 3/8"		Phase 2
018	G	5' - 0"	5' - 0"	2"		Phase 2
LEVEL 2						
008	B	2' - 6"	6' - 8"	1 3/8"		Phase 2
009	B	2' - 6"	6' - 8"	1 3/8"		Phase 2
010	B	2' - 6"	6' - 8"	1 3/8"		Phase 2
011	B	2' - 4"	6' - 8"	1 3/8"		Phase 2
012	E	8' - 0"	6' - 8"	1 3/4"		Phase 2
013	B	2' - 4"	6' - 8"	1 3/8"		Phase 2
014	F	2' - 0"	7' - 0"	1/2"		Phase 2
015	D	5' - 0"	6' - 8"	2"		Phase 2



THOMAS OCHSNER
Architect

ARCHITECTURE & PLANNING

Thomas
Ochsner AIA
Architect

1847 State Street
Santa Barbara, CA 93101
Tel 805.770.7576
Cel 805.705.6558
tom@toarchitect.com
www.toarchitect.com

CLIENT

Emilio Ruggiero

PROJECT

DETACHED
ACCESSORY
DWELLING UNIT

1308 CACIQUE ST, SANTA
BARBARA, CA, 93101

SHEET TITLE

ARCHITECTURAL
DETAILS

REVISIONS


PROJECT NAME DETACHED ACCESSORY
DWELLING UNIT

DATE DRAWN


DATE 12/21/2020

SHEET NO.

A-9.1

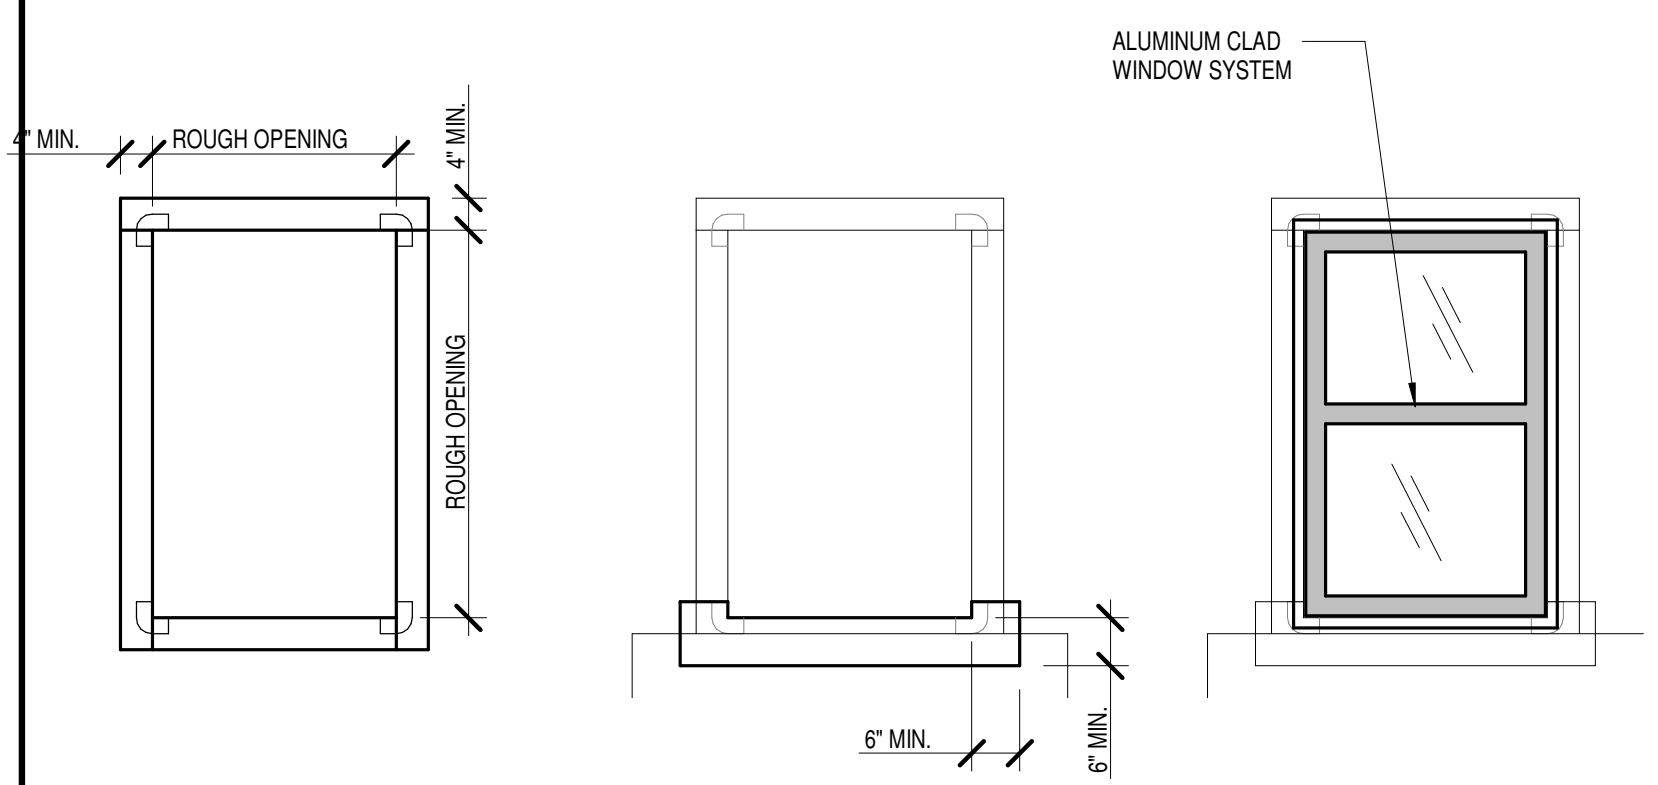


1. APPLY 60 MIL PLIABLE MEMBRANE TAPE OVER SHEATHING AT CORNERS OF ROUGH OPENING - 'JS500' DETAIL TAPE OR EQUAL. APPLY 40 MIL PEEL AND STICK MEMBRANE AT FRAME - P.W. 100/40' OR EQUAL. LAP AS SHOWN.
2. APPLY BUILDING PAPER AT SILL CONDITION. APPLY 20 MIL PEEL AND STICK BUILDING TAPE AT SILL OVER BUILDING PAPER - 'BT20XL' OR EQUAL.
3. INSTALL WINDOW SHIMS AS NECESSARY. INSTALL AND SET WINDOW IN OPENING PER MANUFACTURER'S REQUIREMENTS. MECHANICALLY FASTEN FLANGE TO SUBSTRATE.

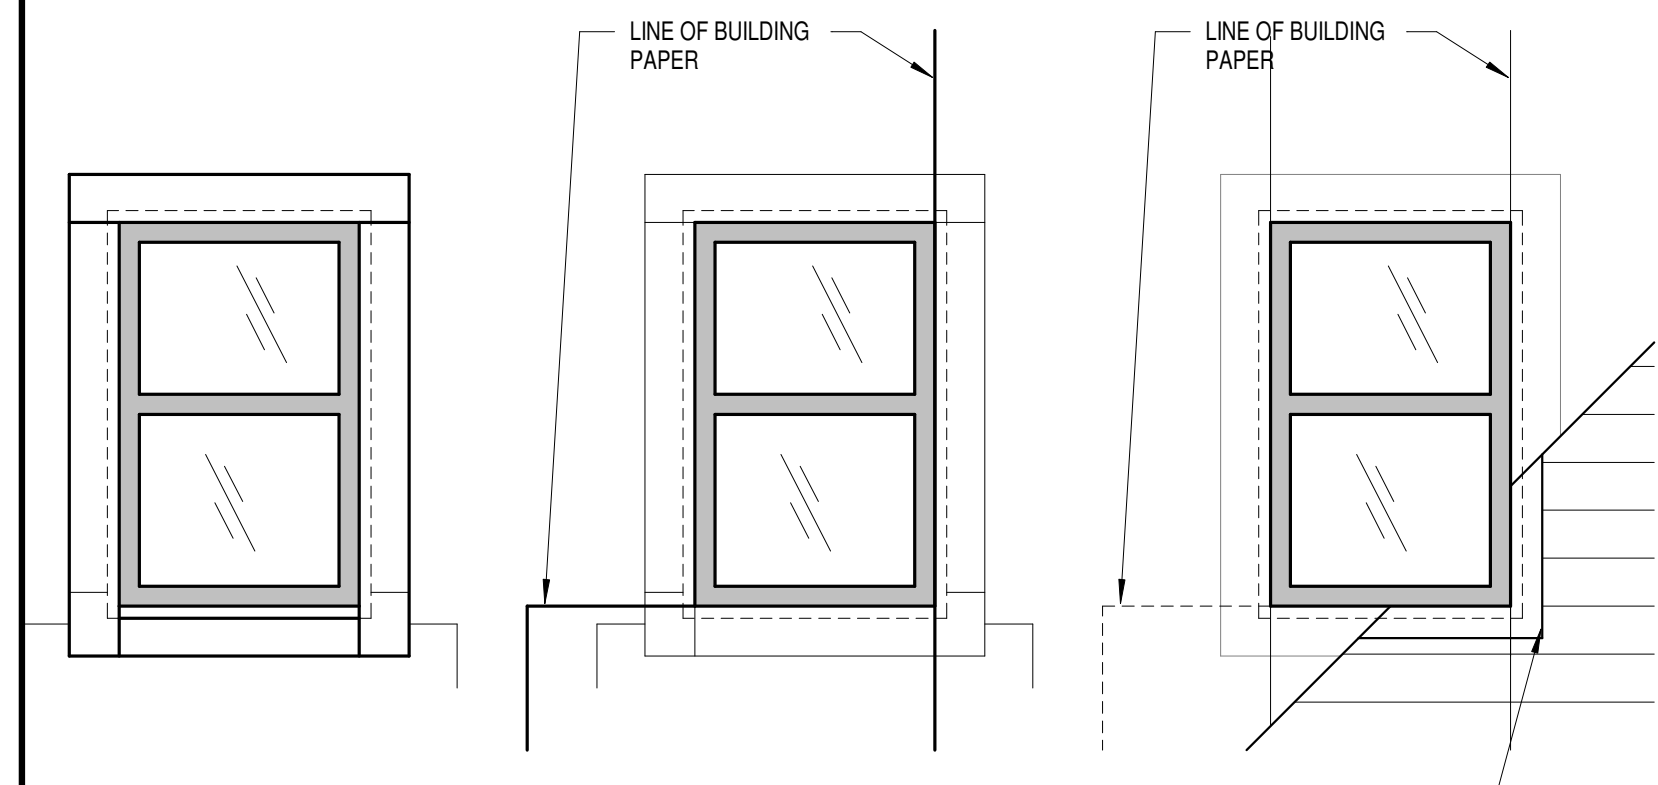


4. APPLY 20 MIL PEEL AND STICK BUILDING TAPE OVER REMAINING SIDES OF WINDOW FLANGE - 'BT20XL' OR EQUAL. LAP AS SHOWN.
5. APPLY BUILDING PAPER OVER WINDOW FLANGES AS SHOWN - MAINTAIN EXTERIOR SIDE OVERLAP. TYPICAL.
6. APPLY EXTERIOR FINISH AND TRIM PER SCHEDULE.

12 WATERPROOFING AT FLANGED WINDOW OPENING (DOOR SIM. @ HEAD/JAMB)
3" = 1'-0"

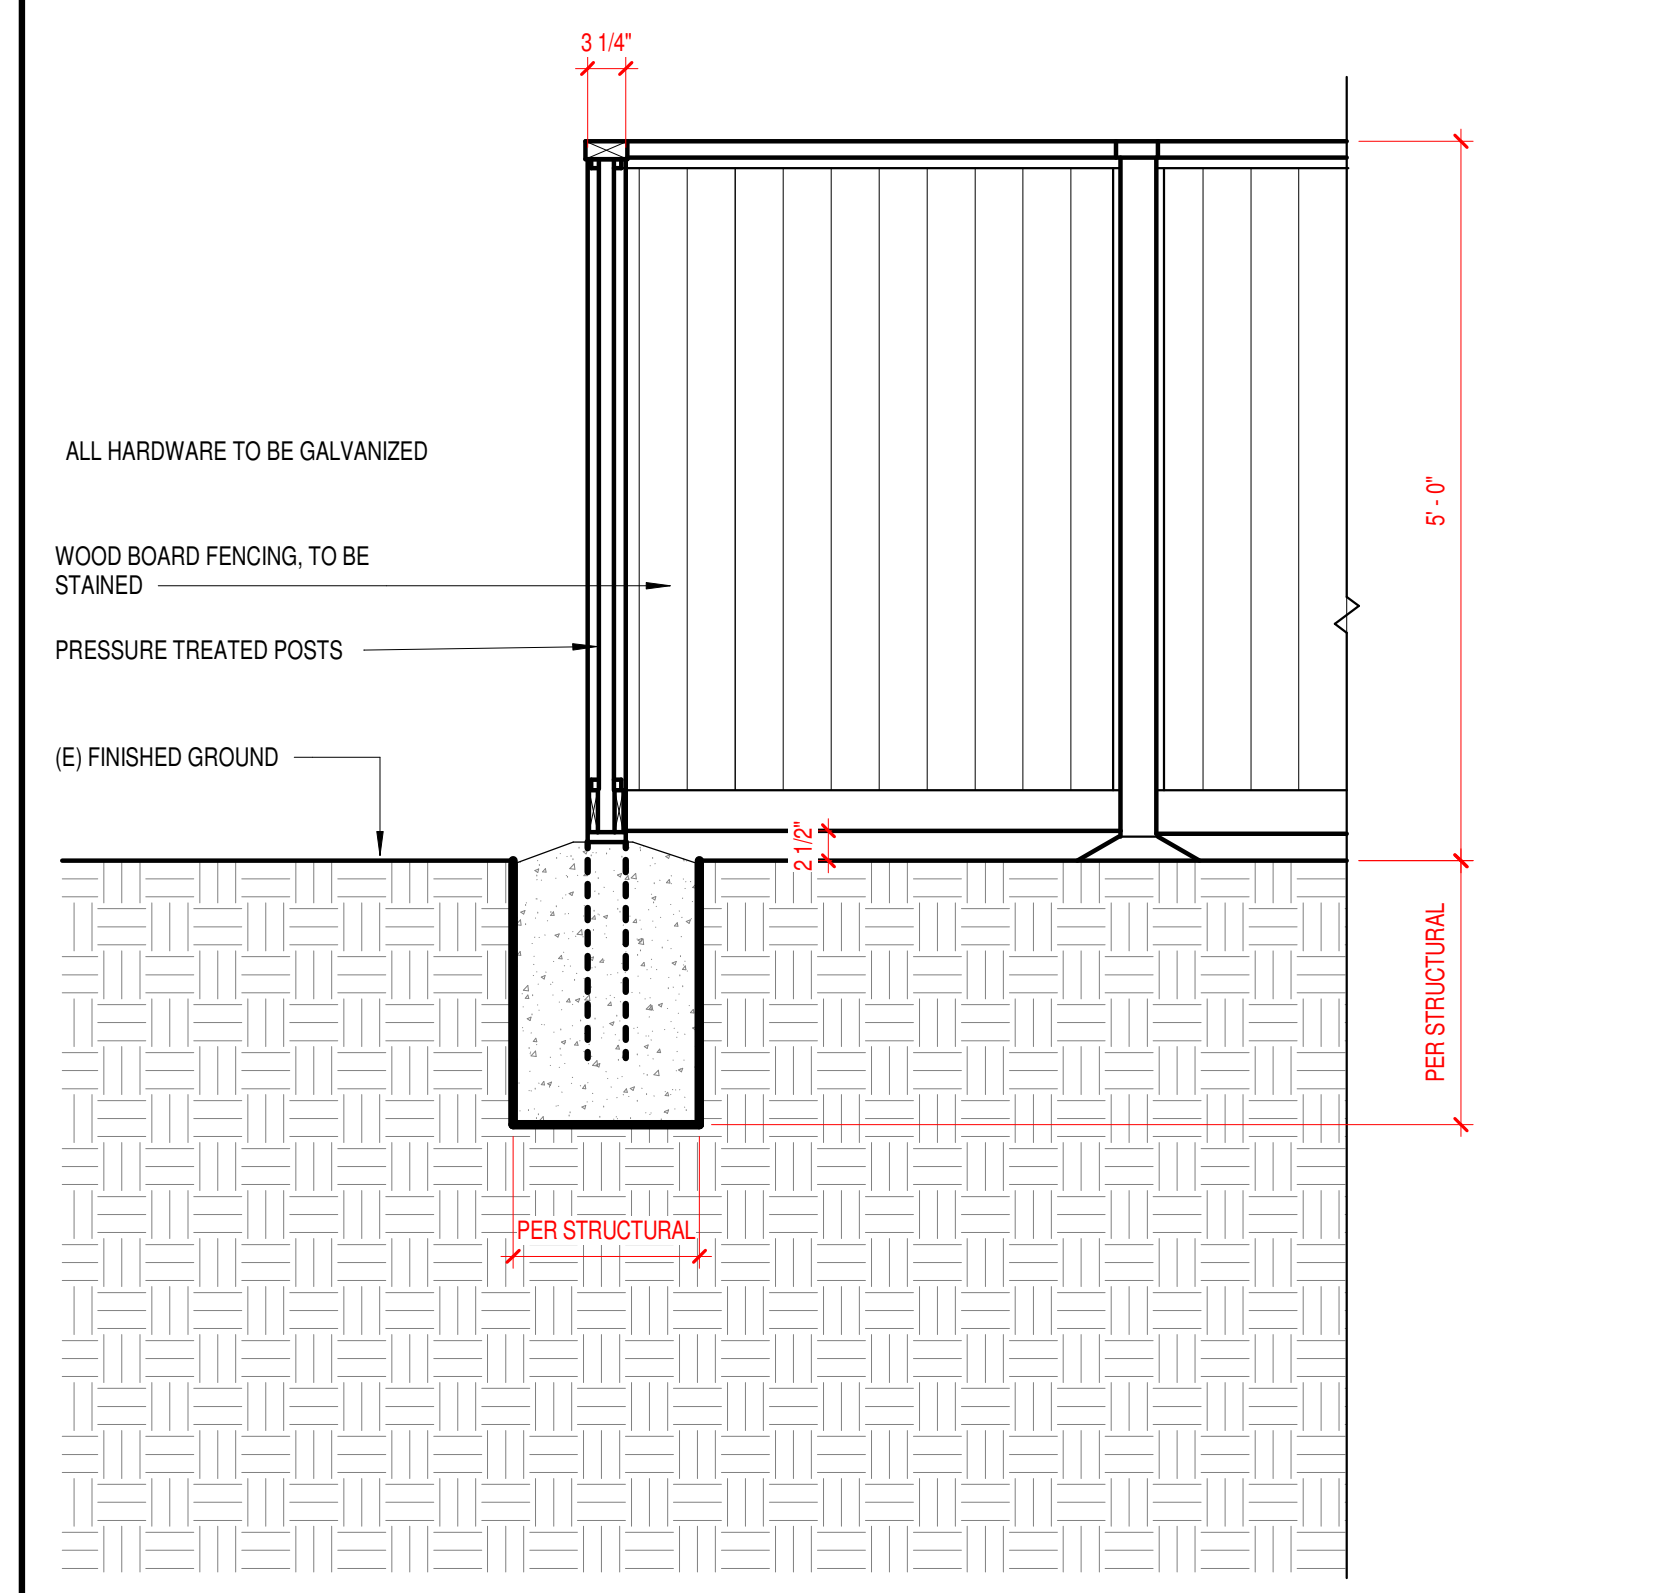


4 FENCING DETAIL
3/4" = 1'-0"

09 INTERIOR DOOR HEAD/JAMB
3" = 1'-0"

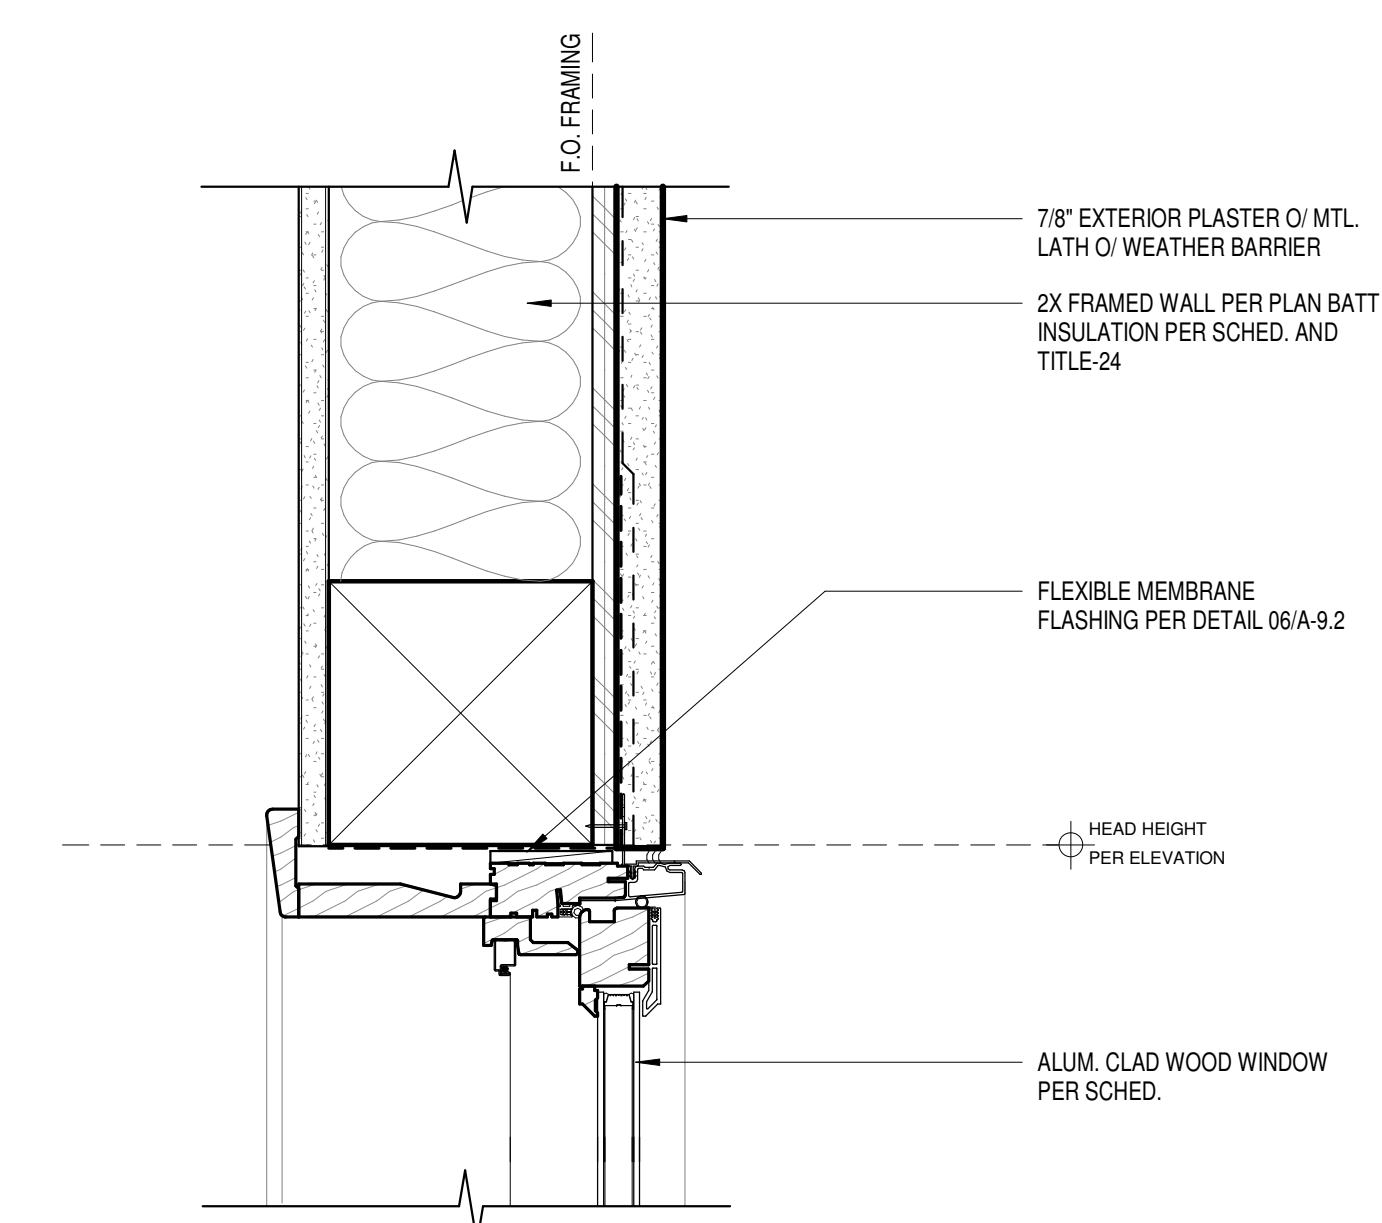


10 WINDOW HEAD/JAMB
3" = 1'-0"

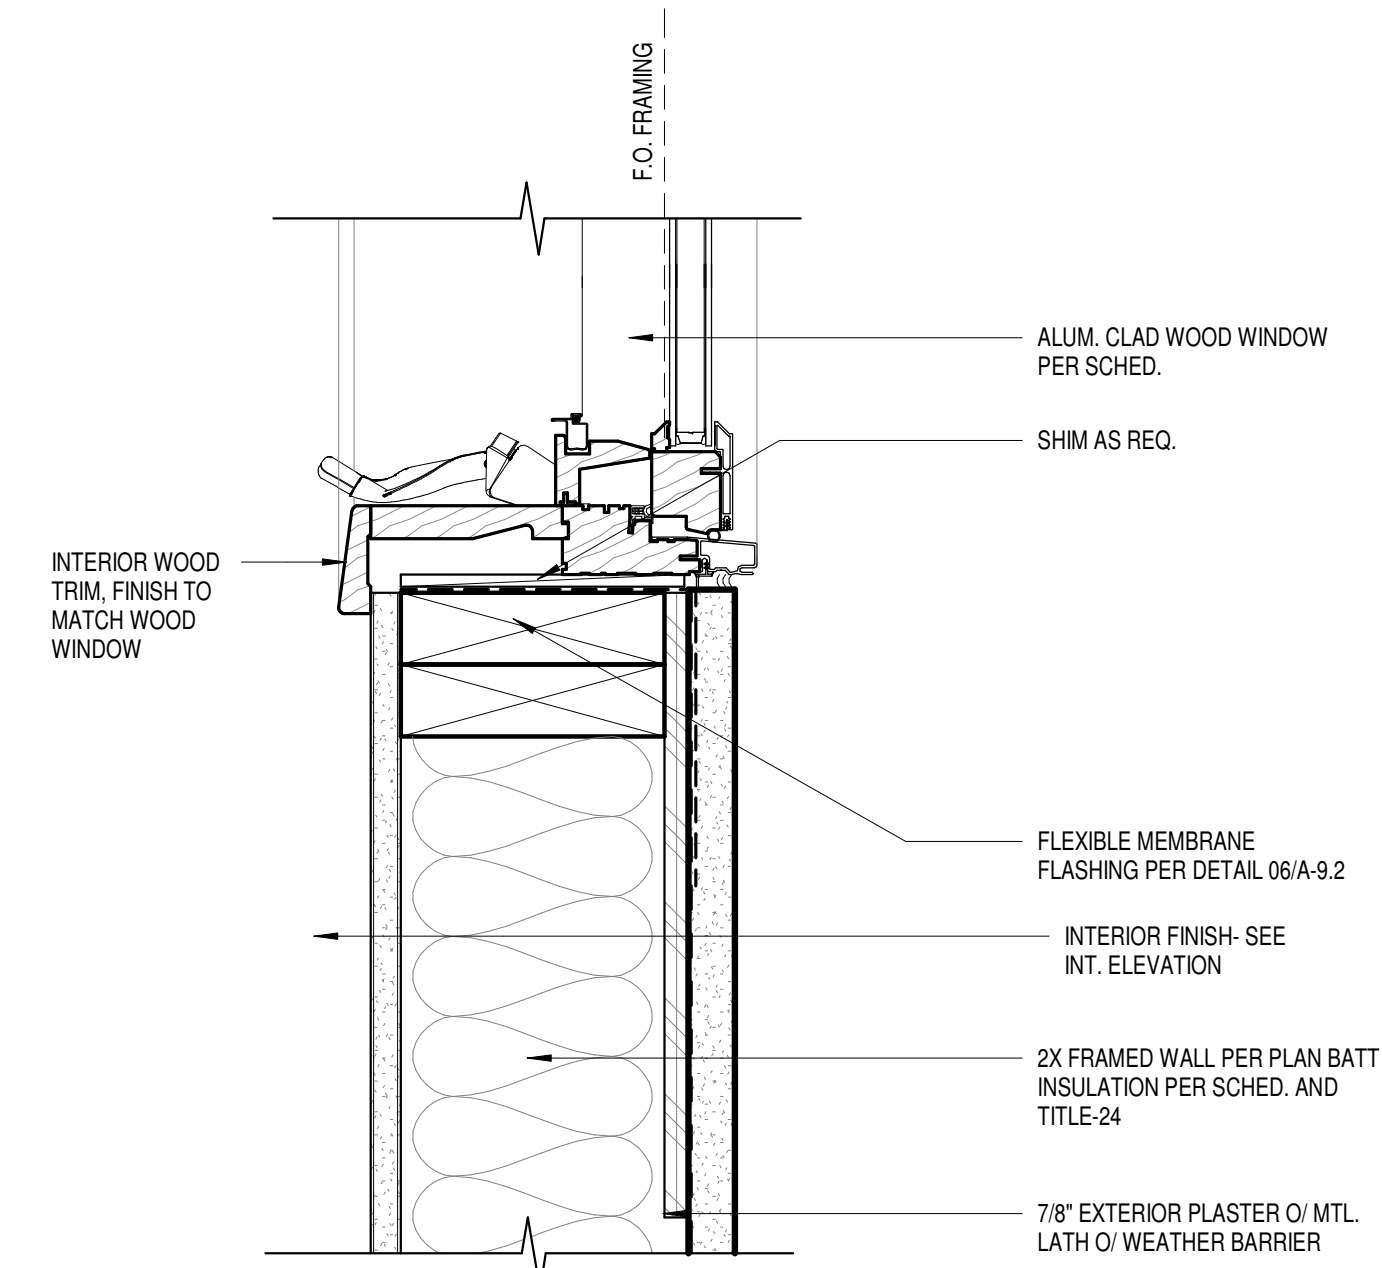


11 WINDOW SILL
3" = 1'-0"



05 DOOR JAMB AT SWING DOOR
3" = 1'-0"

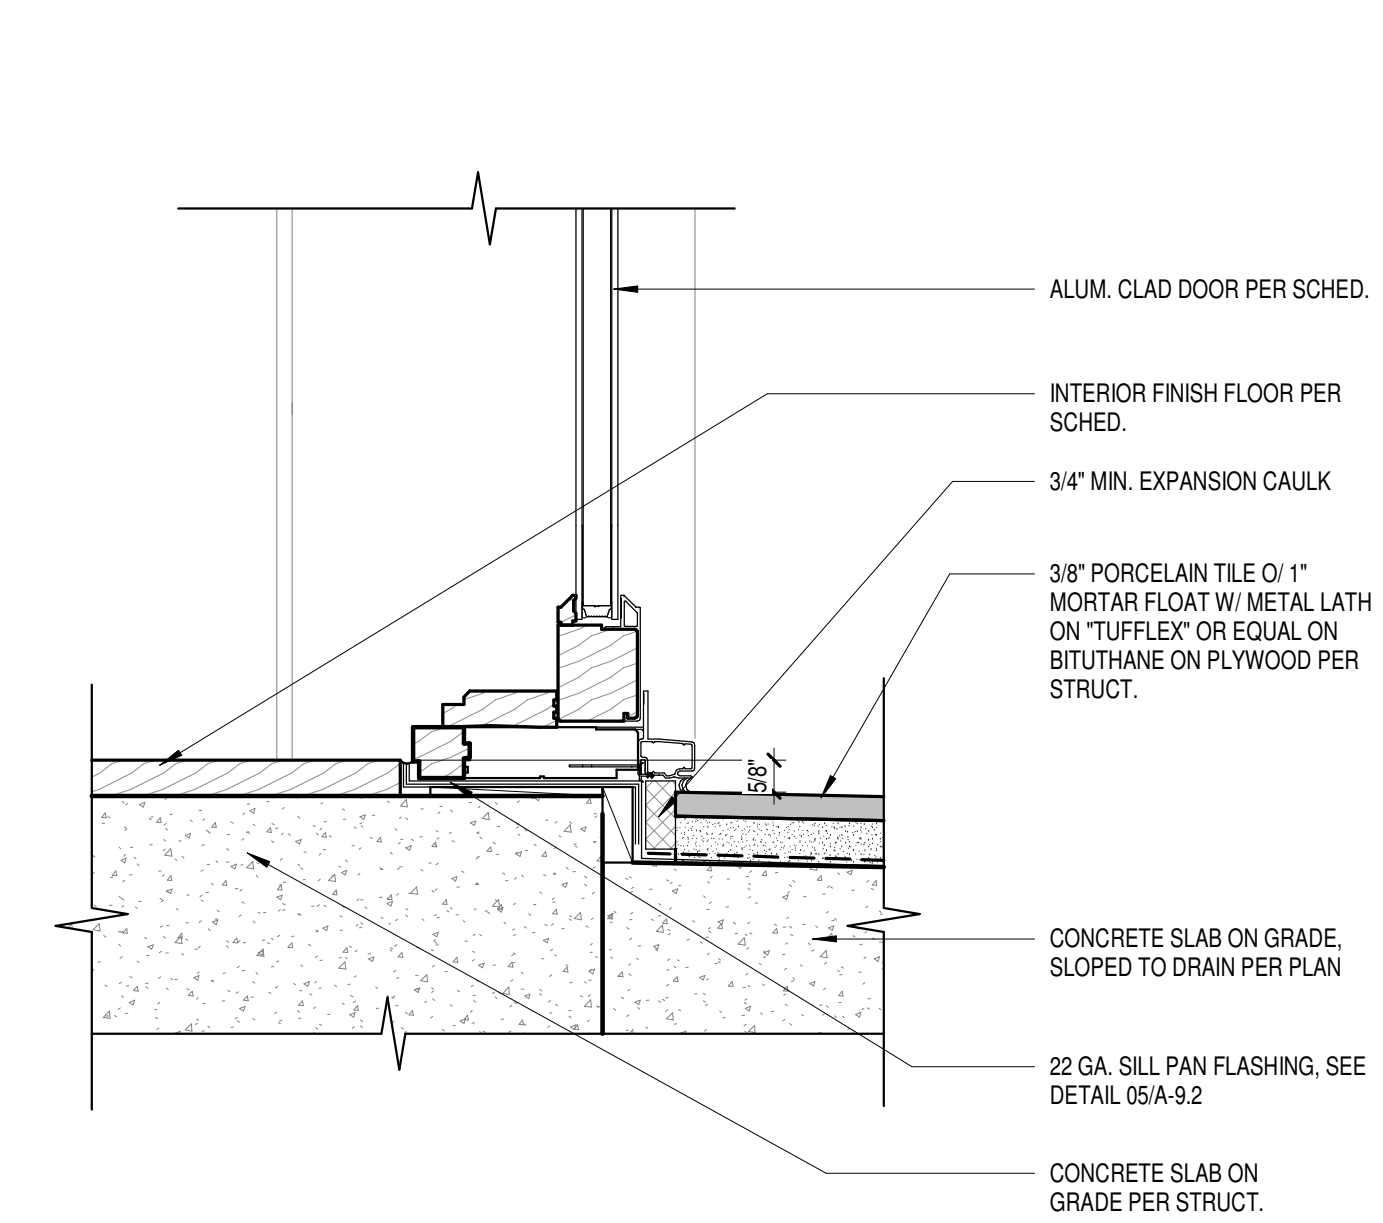


06 DOOR THRESHOLD AT BIFOLD DOOR
3" = 1'-0"

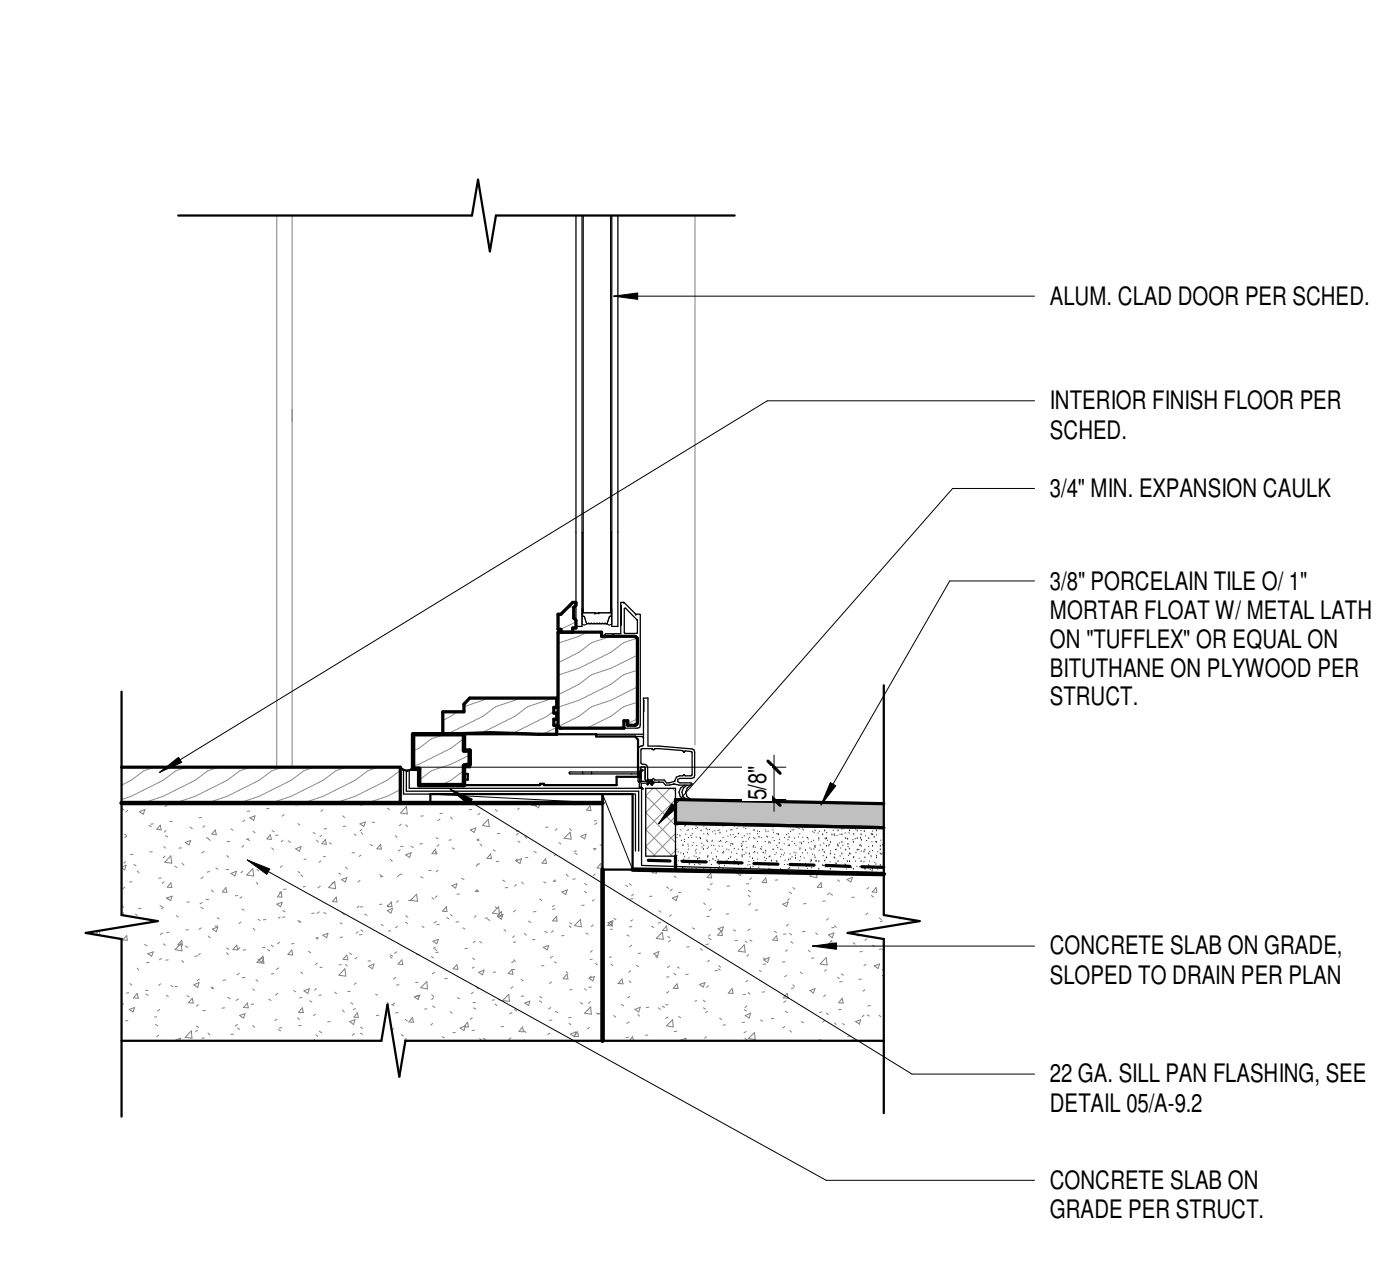


07 DOOR THRESHOLD AT SWING DOOR
3" = 1'-0"



01 DOOR HEAD AT BIFOLD DOOR
3" = 1'-0"

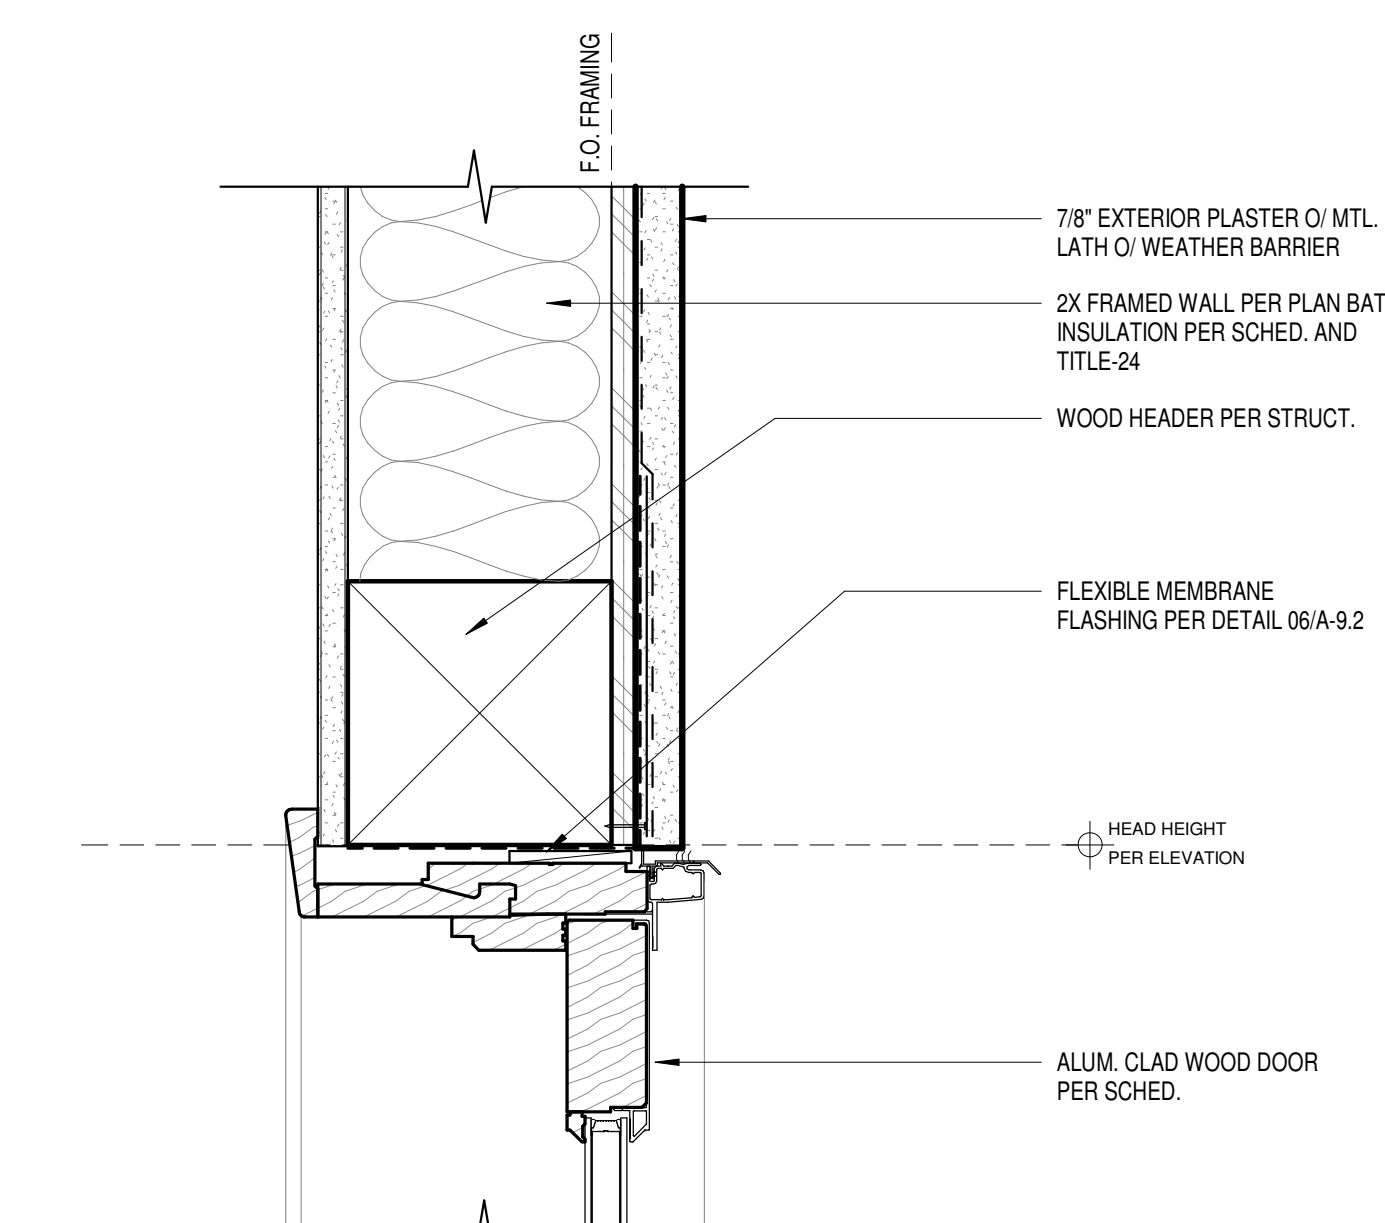

02 DOOR HEAD AT SWING DOOR
3" = 1'-0"

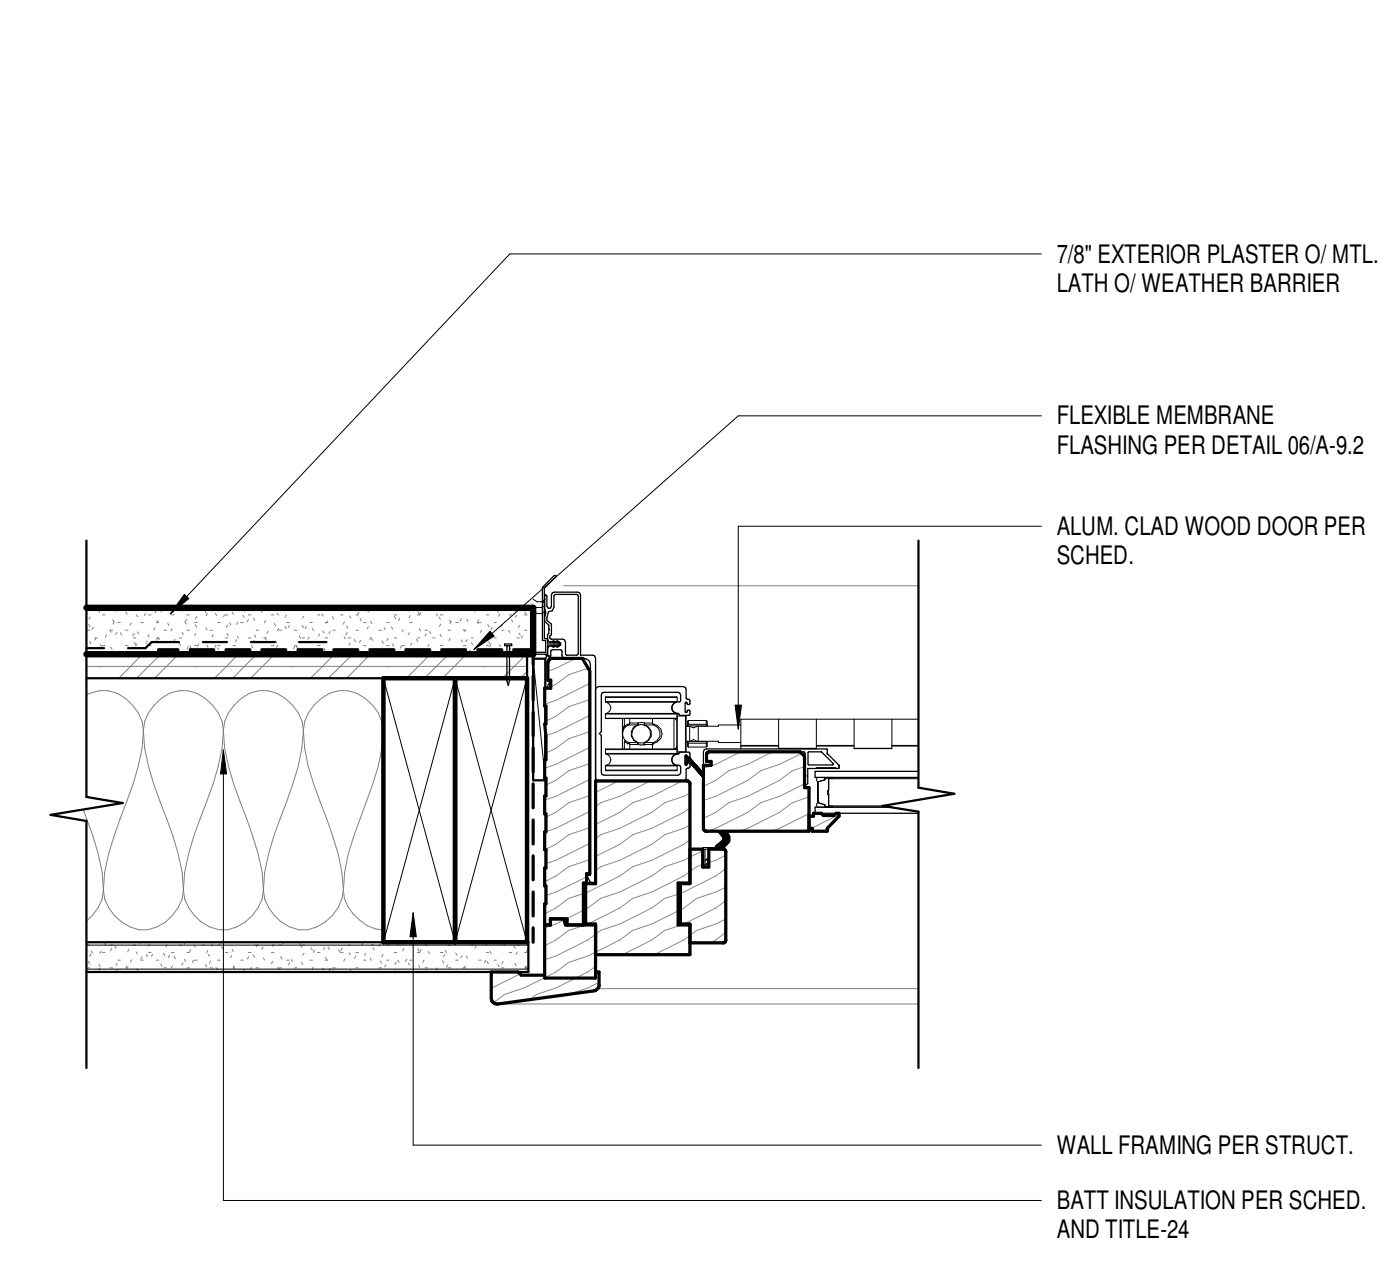

03 DOOR JAMB AT BIFOLD DOOR
3" = 1'-0"





THOMAS OCHSNER
Architect

ARCHITECTURE & PLANNING

Thomas
Ochsner AIA
Architect

1847 State Street
Santa Barbara, CA 93101
Tel 805.770.7576
Cel 805.705.6558
tom@toarchitect.com
www.toarchitect.com

CLIENT

Emilio Ruggiero

PROJECT

DETACHED
ACCESSORY
DWELLING UNIT

1308 CACIQUE ST, SANTA
BARBARA, CA, 93101

SHEET TITLE

LIGHTING & POWER
PLANS

REVISIONS

PROJECT NAME DETACHED ACCESSORY
DWELLING UNIT

DATE DRAWN

DATE 12/31/21

SHEET NO.



E-1

GENERAL NOTES - RCP

- SEE TYPICAL FIXTURE / ACCESSORY MOUNTING HEIGHT DETAIL FOR MOUNTING HEIGHTS.
- LIGHTING FIXTURES IN A SHOWER & WITHIN A BATHTUB AREA & LESS THAN 8 FT ABOVE RIM OF TUB SHALL BE RECESSED AND RATED FOR WET LOCATIONS.
- HARDWIRED SMOKE DETECTORS W/ BATTERY BACK-UP ARE REQUIRED IN EA BEDROOM & IN AREAS LEADING TO BEDROOMS & AT TOP OF STAIRS.
- DUCT OPENINGS AND OTHER RELATED AIR DISTRIBUTION OPENINGS SHALL BE COVERED DURING CONSTRUCTION
- UNLESS FUNCTIONING AS A COMPONENT OF A WHOLE HOUSE VENTILATION SYSTEM, BATHROOM FANS MUST BE CONTROLLED BY A HUMIDISTAT WHICH SHALL BE READILY ACCESSIBLE. HUMIDISTAT CONTROL SHALL BE CAPABLE OF ADJUSTMENT BETWEEN RELATIVE HUMIDITY RANGES OF 50 TO 80%.
- WHOLE HOUSE EXHAUST FAN SHALL HAVE INSULATED LOUVERS OR COVERS WHICH CLOSE WHEN THE FAN IS OFF. COVERS OR LOUVERS SHALL HAVE A MINIMUM INSULATION VALUE OF R-4.2

RCP LEGEND

- MECHANICAL EXHAUST CAPABLE OF 50 CFM. FANS SHALL BE ENERGY STAR COMPLIANT AND SHALL BE DUCTED TO TERMINATE OUTSIDE THE BUILDING. SEE MECH.
- SUPPLY GRILLE, SIZE PER MECH. SUBCONTRACTOR
- RETURN GRILLE, SIZE PER MECH. SUBCONTRACTOR
- 4" RECESSED CAN (SEE ELECTRICAL DRAWINGS)
- INTERIOR SCIENCE
- DECORATIVE PENDANT LIGHT
- NATURAL GAS HOOKUP
- SMOKE DETECTOR
- CARBON MONOXIDE DETECTOR
- EXTERIOR GOOSENECK SCIENCE - DARK SKY COMPLIANT, SEE CUT SHEET

NOTE: SEE LIGHTING PLANS FOR FIXTURE LAYOUT AND INFORMATION

ELECTRICAL LEGEND

- DUPLEX POWER OUTLET
- DEDICATED DUPLEX POWER OUTLET
- DUPLEX POWER OUTLET MOUNTED ABOVE COUNTER, AFF AS NOTED
- GROUNDED DUPLEX OUTLET MOUNTED ABOVE COUNTER, AFF AS NOTED
- OUTDOOR/ WET LOCATION OUTLET
- CABLE TV OUTLET
- DATA OUTLET
- TELEPHONE / DATA OUTLET
- FLUSH BOX, DUPLEX POWER
- FLUSH BOX, QUAD POWER

ELECTRICAL NOTES

MATERIALS:


- ALUMINUM WIRE SHALL NOT BE USED IN ELECTRICAL WIRING WITHIN THE UNIT.
- PROVIDE MATCHING GANG PLATES AT ALL LOCATIONS WHERE TWO OR MORE SWITCHES OCCUR. PROVIDE SAMPLES OF PLATES, SWITCHES AND OUTLETS TO ARCHITECT FOR APPROVAL.

WORKMANSHIP:


- ALL WORK SHALL BE IN ACCORDANCE WITH ALL CODES, RULES AND REGULATIONS OF GOVERNING AGENCIES AND SHALL COMPLY WITH THE REQUIREMENTS OF THE SERVING POWER AND TELEPHONE COMPANIES.
- ALL EQUIPMENT AND MATERIALS FURNISHED AND INSTALLED UNDER THIS SECTION SHALL BE GUARANTEED BY THE CONTRACTOR FOR A PERIOD OF ONE YEAR FROM THE DATE OF ACCEPTANCE OF THE WORK BY THE OWNER.

INSTALLATION:

- ALL EQUIPMENT INSTALLED OUTDOORS AND EXPOSED TO WEATHER SHALL BE "WEATHER-PROOF".
- RECEPTACLES SHALL BE INSTALLED VERTICALLY AT 12" ABOVE FINISH FLOOR TO CENTERLINE OF RECEPTACLE UNLESS NOTED OTHERWISE.
- WALL SWITCHES TO BE ABOVE FLOOR AS DETERMINED BY THE ARCHITECT. (42" ABOVE FLOOR FINISH TO CENTERLINE OF SWITCH UNLESS NOTED OTHERWISE)
- ALL OUTLET LOCATIONS TO BE PER THIS DRAWING- ELECTRICAL ENGINEERS' DRAWINGS FOR CIRCUITRY ONLY
- DO NOT INSTALL OUTLETS BACK TO BACK ON THE SAME PARTITION. WHERE OUTLETS MUST BE LOCATED IN THE SAME STUD CAVITY ON OPPOSITE SIDES OF THE PARTITION, INSTALL A VERTICAL AND HORIZONTAL STUD, AS REQUIRED, SEPARATING SUCH OUTLETS.
- ALL EXPOSED CONDUITS TO BE RIGID- AND ALL EXPOSED J-BOXES TO BE EXTERNAL GRADE
- EXTEND CONDUIT (CONCEALED AT INSIDE OF DESK) FROM CLOSEST ADJACENT WALL TO NOTED LOCATION FOR POWER/VOICE/DATA.
- ELECTRICAL CONTRACTOR TO PROVIDE ALL ROUGH-INS FOR AND FINAL CONNECTIONS TO ALL EQUIPMENT AND FIXTURES SHOWN ON PLANS.
- ELECTRICIAN TO PROVIDE FLEX OR RIGID CONDUIT, AS APPLICABLE, AND WIRING BETWEEN CONTROL SWITCHES AND LOADS FOR EQUIPMENT AS REQUIRED AND SHOWN ON EQUIPMENT PLANS AND SCHEDULES.
- ALL HORIZONTAL DIMENSIONS ARE GIVEN FROM FACE OF FINISHED WALL TO CENTER-LINE OF OUTLET OR FROM CENTER-LINE OF OUTLET TO CENTER-LINE OF OUTLET UNLESS OTHERWISE NOTED. ALL OUTLETS NOTED PLUS 12" PLUS 24" ETC., TO STUB-OUT OF FINISHED FLOOR (NOT TOP OF FINISHED CURB) TO CENTER-LINE OF OUTLET. OUTLETS NOTED STUB-UP TO STUB-OUT OF FINISHED AT LOCATION SHOWN, AND TO STUB-UP MAXIMUM 4" ABOVE FINISHED FLOOR OR CURB, U.N.O.
- ELECTRICAL CONTRACTOR TO SIZE, PROVIDE AND MOUNT ALL ELECTRICAL J-BOXES IN FIXTURES. FIXTURE FABRICATOR TO PROVIDE AND MOUNT ALL CONVENIENCE OUTLET BOXES AND SWITCHES WHERE PART OF FIXTURE SPLASH BUT RECEPTACLES, CONDUITS, AND WIRING FOR ALL SUCH BOXES TO BE SUPPLIED AND INSTALLED BY ELECTRICAL CONTRACTOR. ALL CONVENIENCE OUTLETS IN WALL TO BE FLUSH UNLESS OTHERWISE NOTED. ELECTRICIAN TO PROVIDE EXTENSION SHIELDS WHERE REQUIRED. FIXTURE FABRICATOR WILL PROVIDE ACCESS IN FIXTURE FOR ELECTRICIAN.
- CLIENT TO APPROVE ELECTRICAL AND DATA LOCATIONS WITH ARCHITECT AND CONTRACTOR PRIOR TO INSTALLATIONS.
- LOCATIONS OF (N) DROPS ARE FOR PRACTICAL ARCHITECTURAL REASONS ONLY. CONTRACTOR TO VERIFY SIZE AND AMOUNTS OF DROPS NECESSARY FOR PROPER POWER SUPPLY, ETC. TO WORKSTATIONS. CONTRACTOR MAY ADD ADDL AS REQUIRED, PROVIDING LOCATION BE VERIFIED WITH ARCHITECT.
- CONTRACTOR MAY USE ANY (E) RECEPTACLES WHERE APPLICABLE.
- CONTRACTOR TO VERIFY THAT CIRCUIT DEDICATION IS AS SHOWN ON THE PLAN. ANY DISCREPANCIES BETWEEN DRAWINGS AND (E) FIELD CONDITIONS SHALL BE ADDRESSED IN THE BID NUMBERS.
- ELECTRICAL AND DATA SHOWN ON THIS PLAN ARE FOR LOCATION PURPOSED ONLY. SEE ELECTRICAL PLANS FOR CIRCUITING AND ADDITIONAL INFORMATION.
- CONTROLS AND SWITCHES INTENDED TO BE USED BY THE OCCUPANT OF THE ROOM OR AREA TO CONTROL LIGHTING AND RECEPTACLE OUTLETS, APPLIANCES, OR COOLING, HEATING, AND VENTILATING EQUIPMENT, SHALL BE LOCATED NO MORE THAN 48 INCHES MEASURED FROM THE TOP OF THE OUTLET BOX NOR LESS THAN 15 INCHES MEASURED TO THE BOTTOM OF THE OUTLET BOX TO THE LEVEL OF THE FINISH FLOOR OR WALKING PLATFORM. (1117B.6.5.1).
- ELECTRICAL RECEPTACLE OUTLETS ON BRANCH CIRCUITS OF 30 AMPERES OR LESS AND COMMUNICATION SYSTEM RECEPTALS SHALL BE LOCATED NO MORE THAN 48 INCHES MEASURED FROM THE TOP OF THE RECEPTACLE OUTLET BOX NOR LESS THAN 15 INCHES MEASURED TO THE BOTTOM OF THE RECEPTACLE OUTLET BOX OR RECEPTACLE HOUSING TO THE LEVEL OF THE FINISH FLOOR OR WALKING PLATFORM. (1117B.6.5.1)

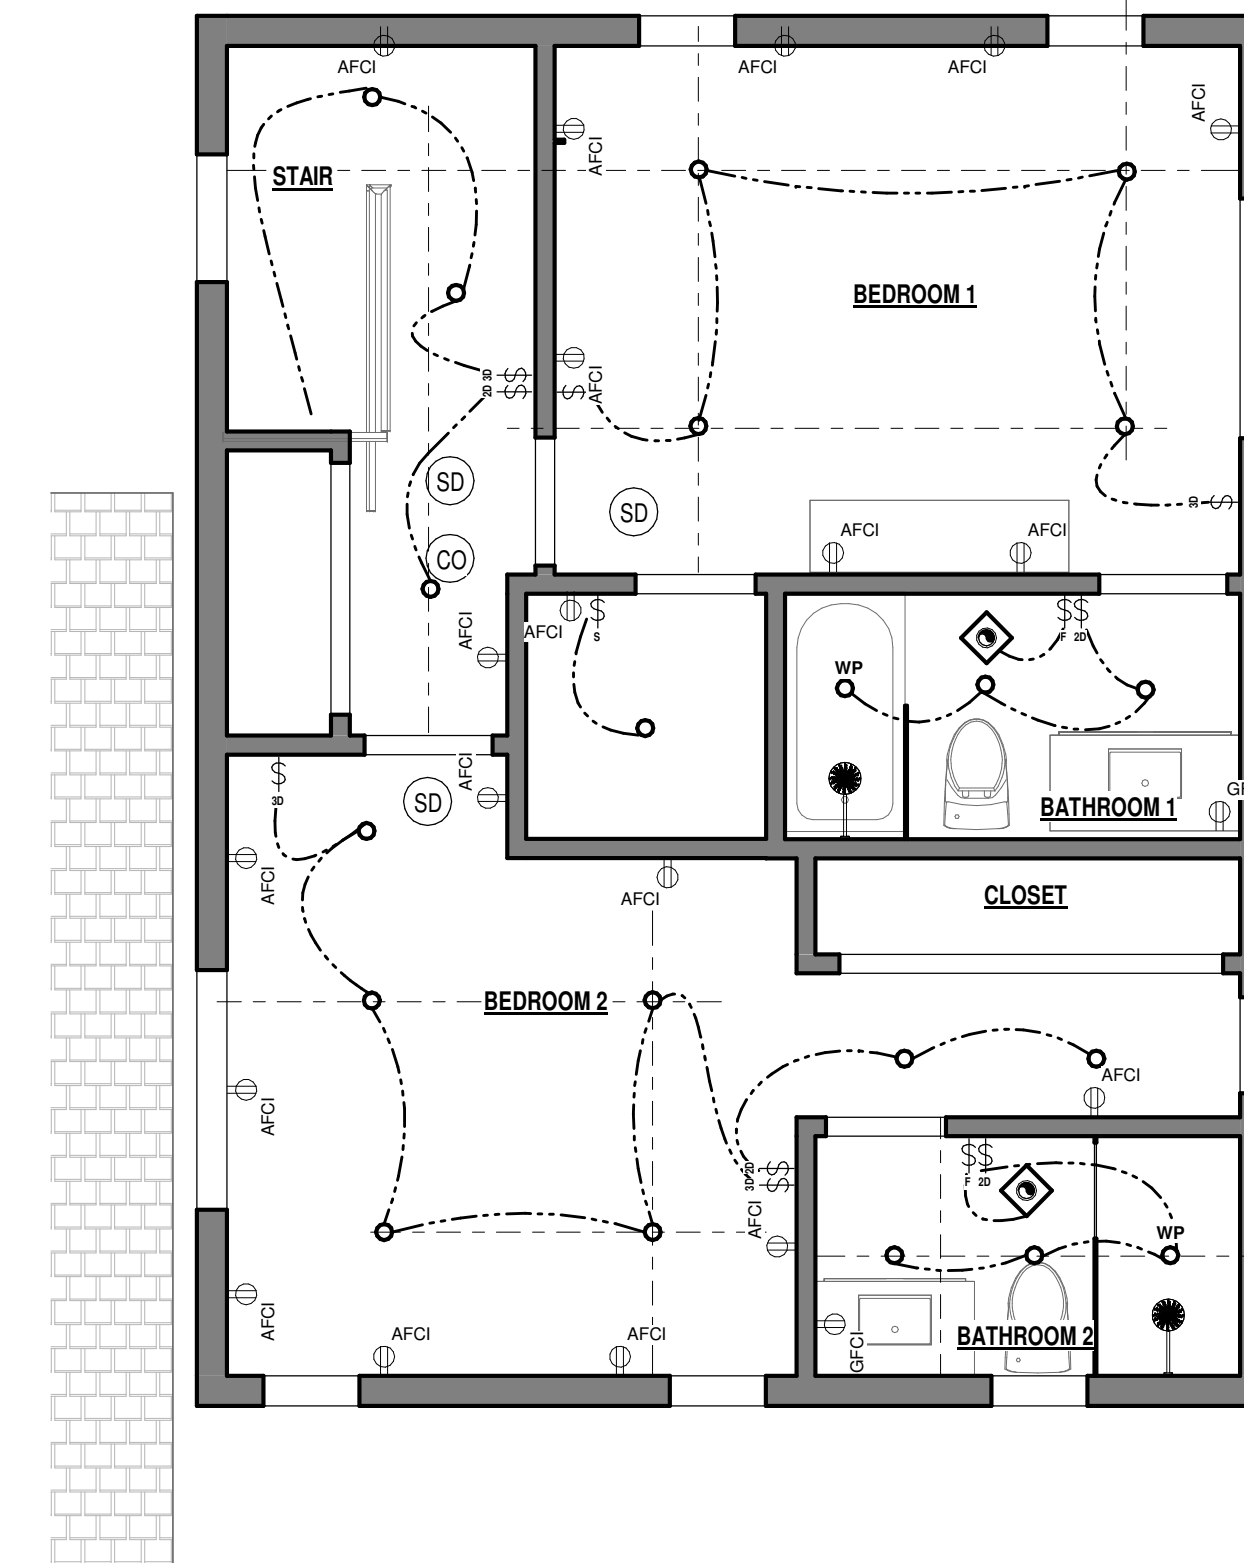

2ND UNIT - LEVEL 2 ELECTRICAL PLAN 2
SCALE: 1/4" = 1'-0"

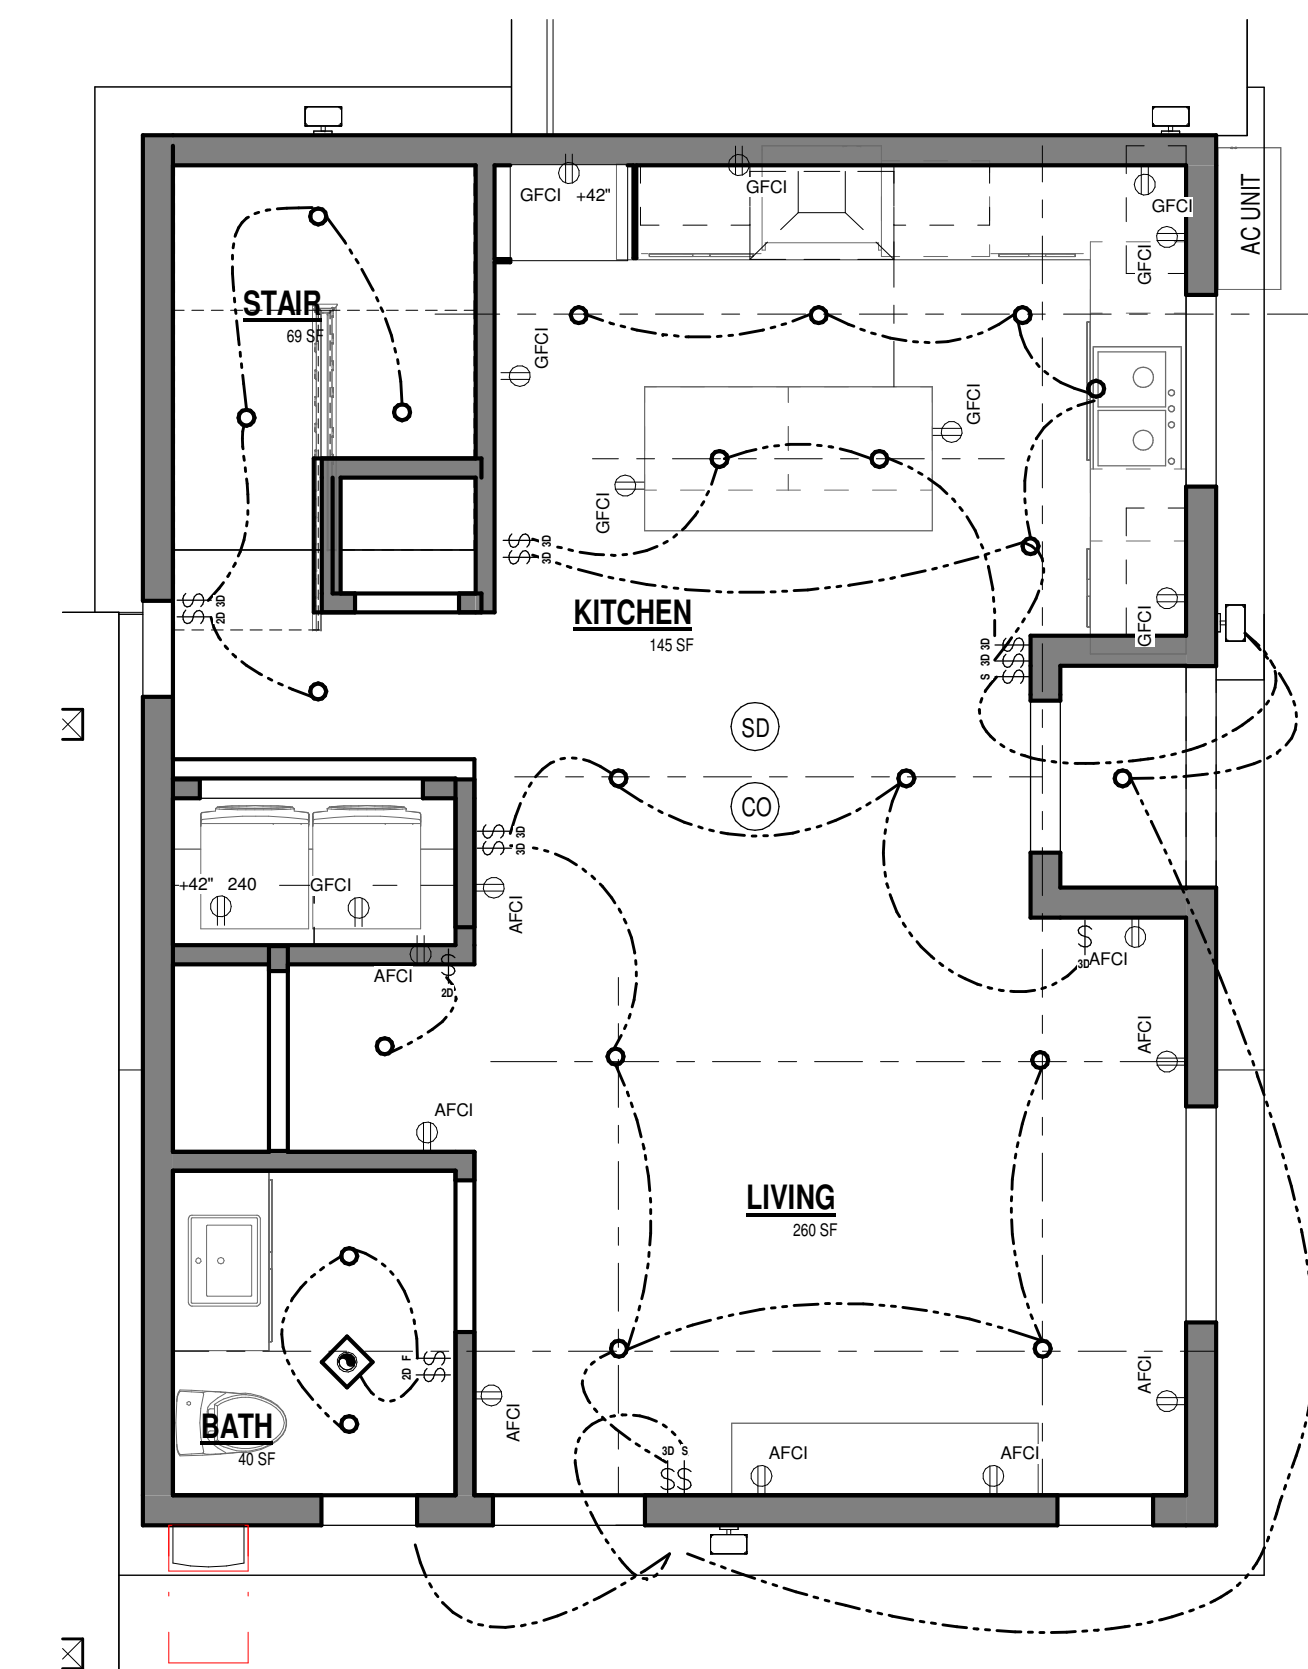

2ND UNIT - LEVEL 1 ELECTRICAL PLAN 1
SCALE: 1/4" = 1'-0"

M-SERIES SUBMITTAL DATA: MS2-GL12NA-U1 & MUZ-GL12NA-U1
15,000 BTU/H WALL-MOUNTED HEAT PUMP SYSTEM

Job Name: _____ Date: _____
System Reference: _____

Electrical Power Requirements:
208 / 230V, 1-Phase, 60 Hz

Minimum Circuit Ampacity (MCA):
Indoor / Outdoor A 1 / 8

Indoor Unit:
Blower Motor (ECM) FLA 0.76
Blower Motor Output W 30
SHF (Moisture Removal) 0.740 / 2.5 ps/h
Flood Drainage Size O.D. (inches) 5/8 (15)

Outdoor Unit:
Compressor DC INVERTER-driven Twin Rotary
Fan Motor (ECM) FLA 0.8

Minimum Room (Cooling) Load (W):
Indoor (Cooling) WET 145-170-237-321-389
Indoor (Heating) DRY 109-134-201-286-364
Outdoor (Heating) DRY 145-170-237-321-406
Outdoor 1,229 / 1,172

Sound Pressure Level (SPL) (dB):
Indoor Cooling 19-22-30-37-45
Indoor Heating 19-22-30-37-43
Outdoor Cooling 49
Outdoor Heating 51

External Dimensions:
Indoor (H x W x D) 11-5/8 x 31-7/16 x 9-1/8 (295 x 798 x 232)
Outdoor (H x W x D) 21-5/8 x 31-1/2 x 11-1/4 (550 x 800 x 285)

Net Weight:
Indoor 22 (10)
Outdoor 81 (37)

External Finish:
Indoor Marquise 1.09 x 2.1 (2.7)
Outdoor Marquise No. 317.2 / 1.1

Refrigerant: R410A, 2 lb, 9 oz.

Refrigerant Piping (Feet):
Liquid (High Pressure) 1/4 (0.35)
Indoor 3/8 (0.52)
Max. Total Refrigerant Pipe Length (Height DR) 40 (12)
Max. Total Refrigerant Pipe Length (Length) 65 (20)

Indoor Unit Efficiency Ratings:
SEER / HSPF 23.1 / 12.5
COP at 47°F / 17°F 3.84 / 3.1

Energy Star®: Yes

ENERGY STAR products are products certified by an EPA-Recognized Certification Body. Specifications are subject to change without notice. © 2018 Mitsubishi Electric US, Inc.

Calculation of the sound level L_2 , which is found at the distance r_2

Reference distance r_1 from sound source	Sound level L_1 at reference distance r_1	Search for L_2
1.00 m or ft	51 dBSPL	
Another distance r_2 from sound source	Sound level L_2 at another distance r_2	Sound level difference $\Delta L = L_1 - L_2$
10 m or ft	31 dBSPL	20 dB

Buttons: calculate, reset